




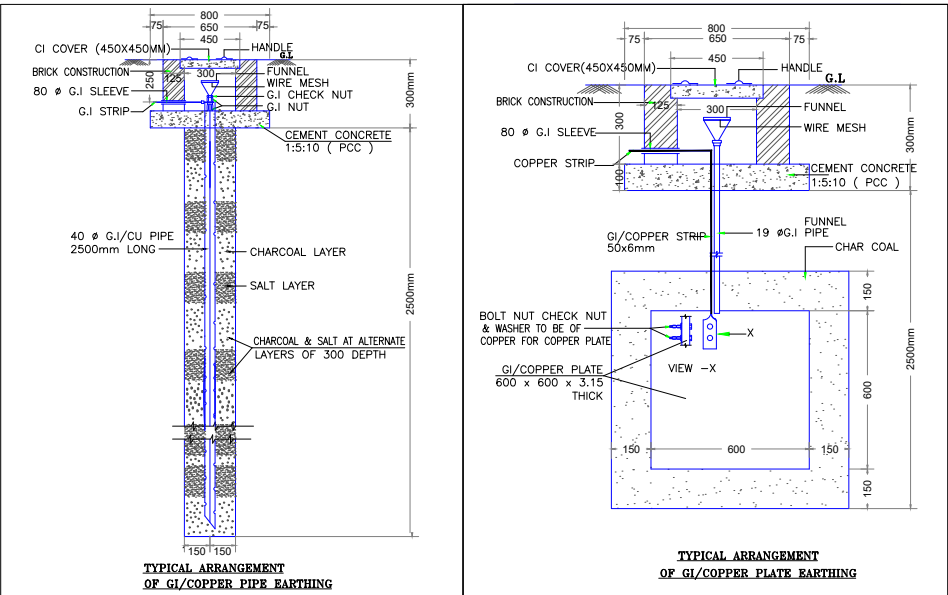

GENERAL BODY EARTHING FOR LT PANELS & DBS

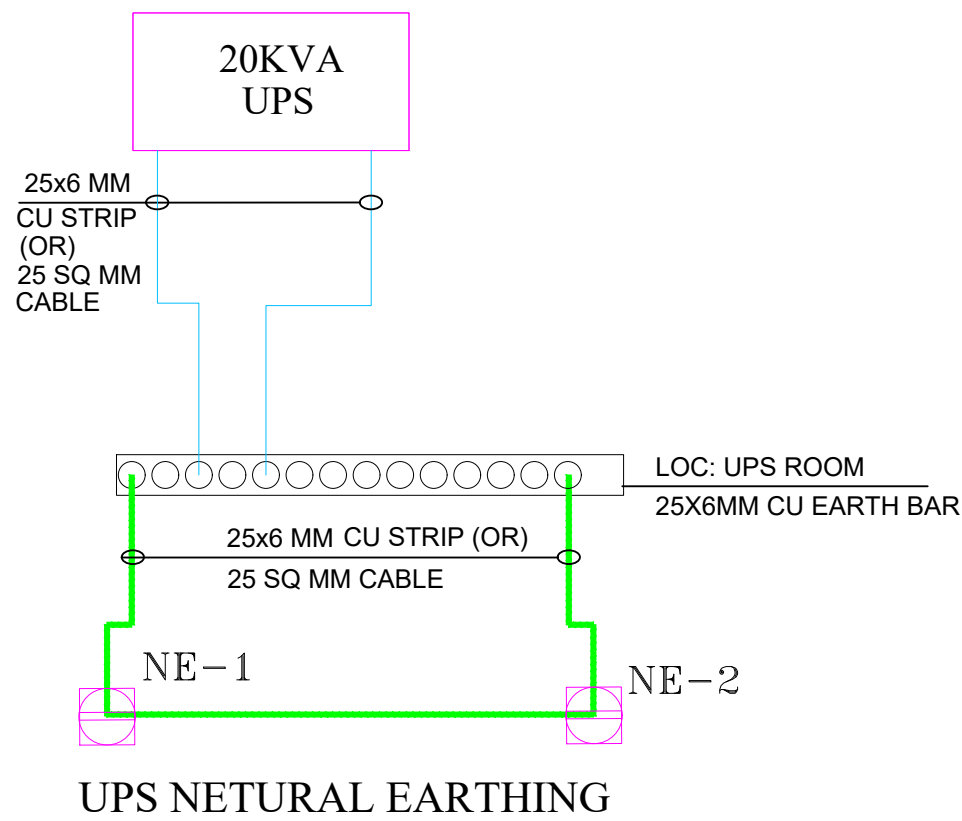

EARTHING SCHEMATIC

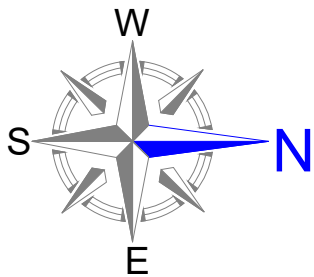

TITLE : EARTHING SCHEMATIC LAYOUT		CLIENT : TELANGANA STATE MEDICAL SERVICES AND INFRASTRUCTURE DEVELOPMENT CORPORATION.		PROJECT : IFV CENTER ON SECOND FLOOR IN MOTHER & CHILD HOSPITAL BUILDING BESIDE GANDHI HOSPITAL , SECUNDERABAD ,TELANGANA.	
PURPOSE OF DRAWING :- PROPOSED <input type="checkbox"/> FOR APPROVAL <input type="checkbox"/> WORKING <input type="checkbox"/> AS BUILT <input checked="" type="checkbox"/>		DWG. No.: AVC/TGMSIDC/IVFG/ELE/04		CONTRACTOR : <div><div><div>M/s Asta Vardhman Consortium H. NO. 8-2-334/27, Plot No. 27, Road No. 03, Banjara Hills, Hyderabad - 500034</div></div><div></div></div>	
		REV	R4	DATE	04-06-2024
		SCALE	NTS	SHEET	07

