




PLAN

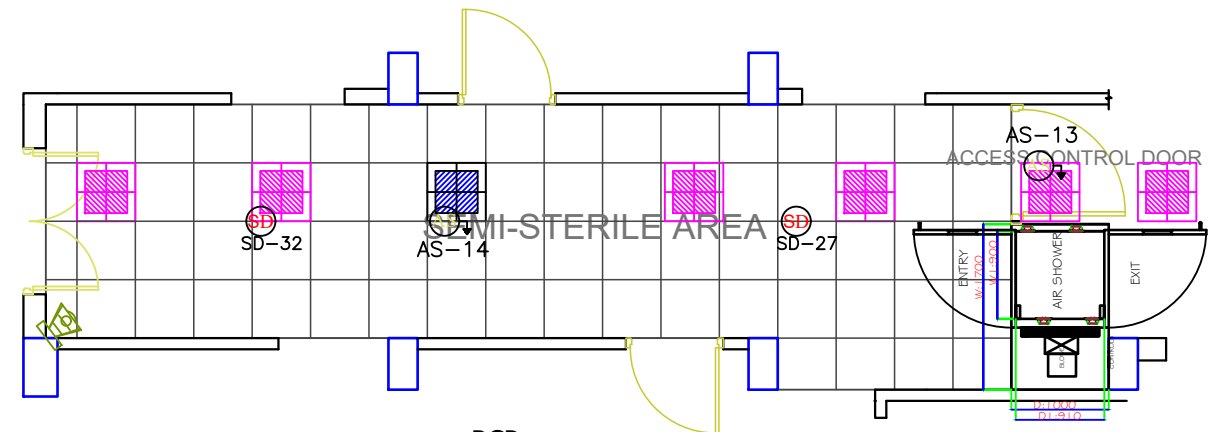


RCP

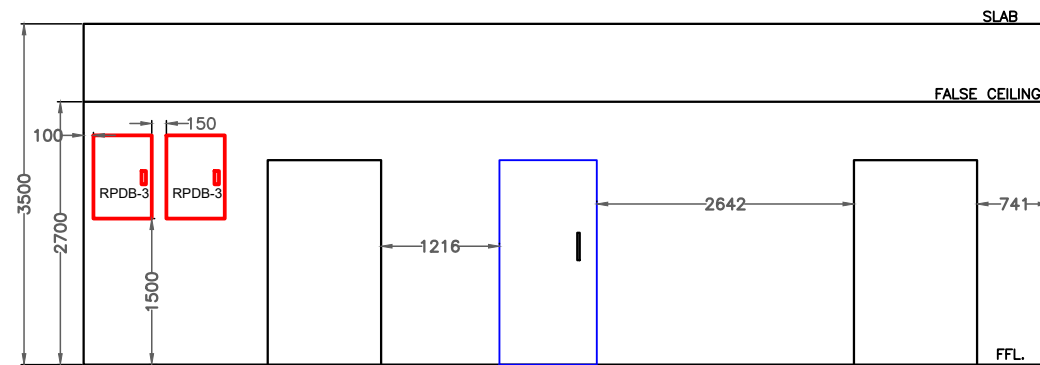


ELEVATION-1

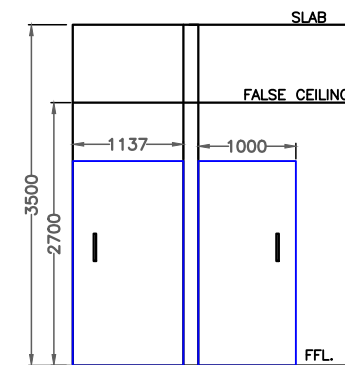


ELEVATION-2

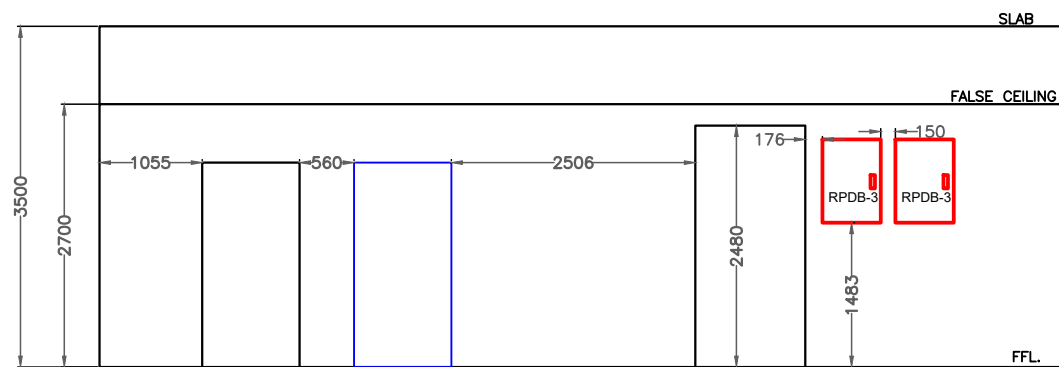

ELEVATION-3

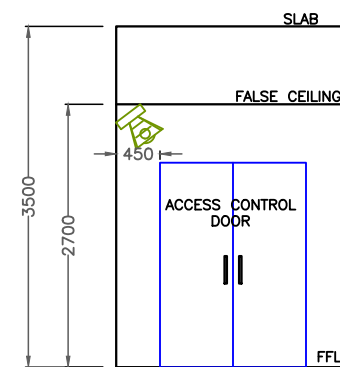

ELEVATION-4

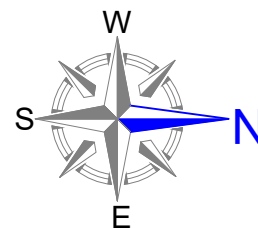

**TITLE :**  
SEMI STERILE CORRIDOR  
ELEVATION LAYOUT

**PURPOSE OF DRAWING :-**

PROPOSED ☐ FOR APPROVAL ☐  
WORKING ☐ AS BUILT ☒

**CLIENT :**

TELANGANA STATE MEDICAL  
SERVICES AND INFRASTRUCTURE  
DEVELOPMENT CORPORATION.

DWG. No.:

AVC/TGMSIDC/IVFP/S/31


REV R2 DATE 20-06-2024

SCALE NTS SHEET 31

**PROJECT :**

IFV CENTER ON THIRD FLOOR IN MODERN  
GOVERNMENT MATERNITY HOSPITAL,  
PETLABURJ, HYDERABAD ,TELANGANA.

CONTRACTOR :

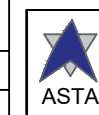

M/s Asta Vardhman Consortium  
H. NO. 8-2-334/27, Plot No. 27,  
Road No. 03, Banjara Hills,  
Hyderabad - 500034

