




PLAN

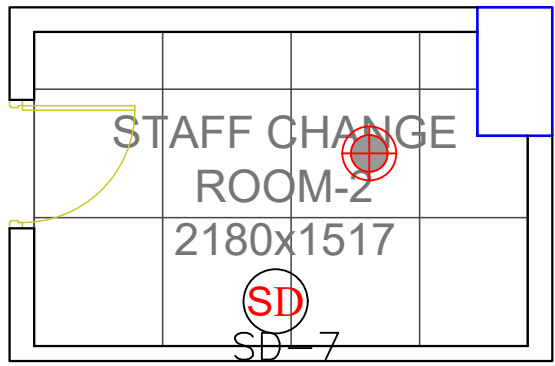


RCP

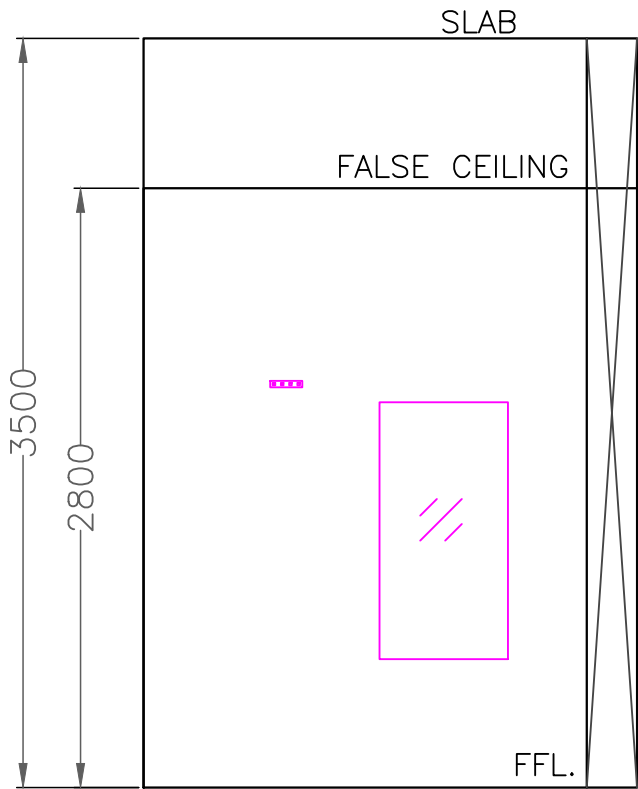


ELEVATION-1

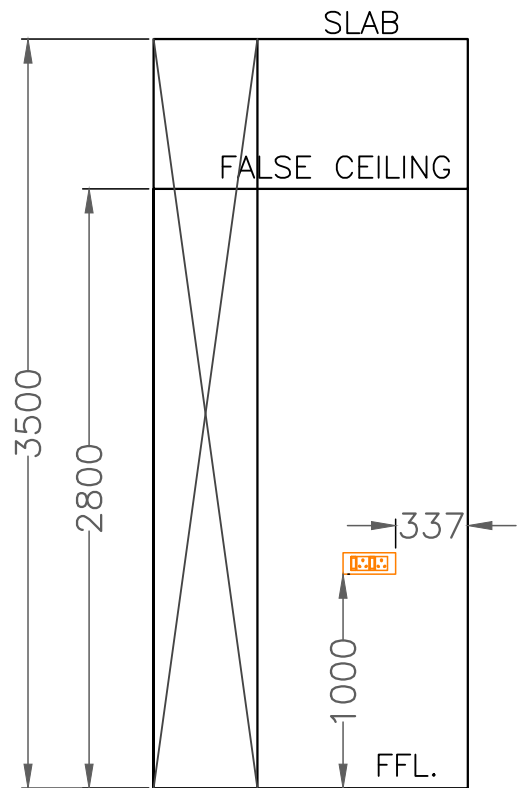


ELEVATION-2

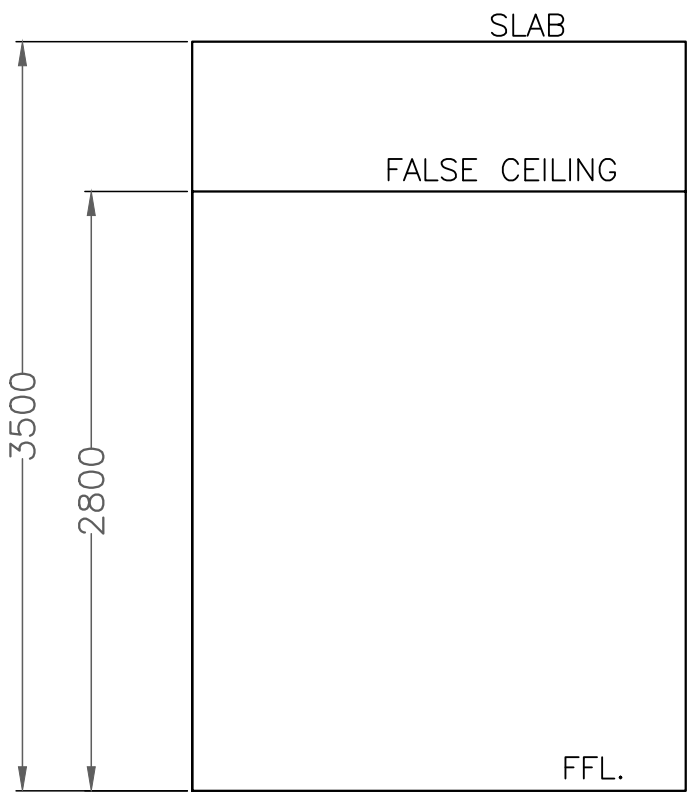

ELEVATION-3

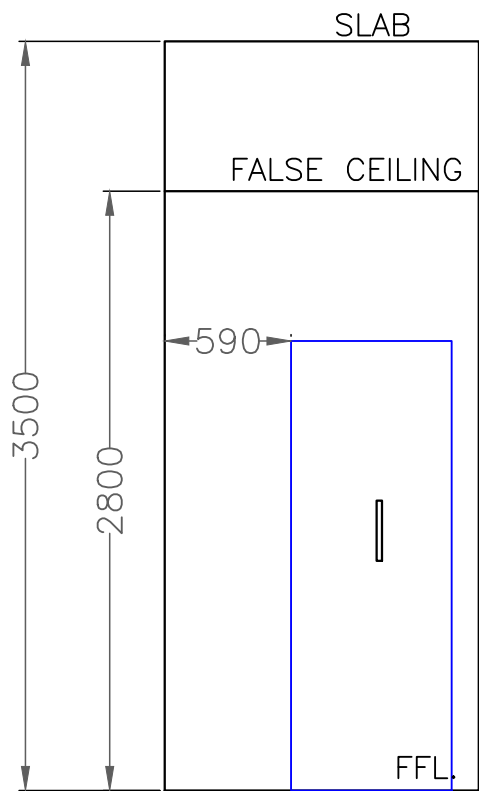

ELEVATION-4

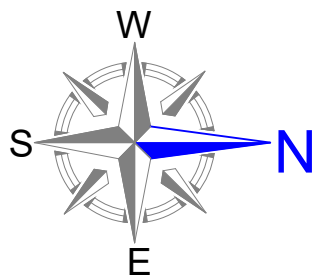


TITLE :
STAFF CHANGE ROOM-2
ELEVATION LAYOUT

CLIENT :
TELANGANA STATE MEDICAL
SERVICES AND INFRASTRUCTURE
DEVELOPMENT CORPORATION.

PROJECT :
IFV CENTER ON THIRD FLOOR IN MODERN
GOVERNMENT MATERNITY HOSPITAL,
PETLABURJ, HYDERABAD ,TELANGANA.

PURPOSE OF DRAWING :-
PROPOSED ☐ FOR APPROVAL ☐
WORKING ☐ AS BUILT ☒

DWG. No.:
AVC/TGMSIDC/IVFP/S/34
REV R2 DATE 20-06-2024
SCALE NTS SHEET 34

CONTRACTOR :
 M/s Asta Vardhman Consortium
H. NO. 8-2-334/27, Plot No. 27,
Road No. 03, Banjara Hills,
Hyderabad - 500034
