




PLAN

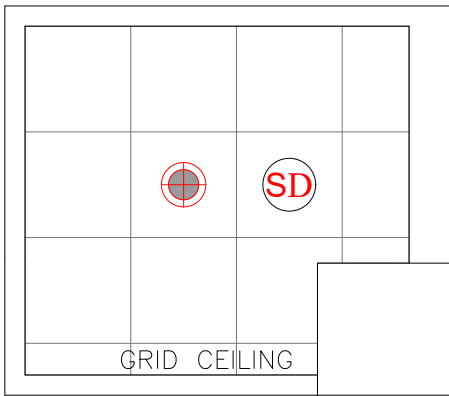


RCP PLAN

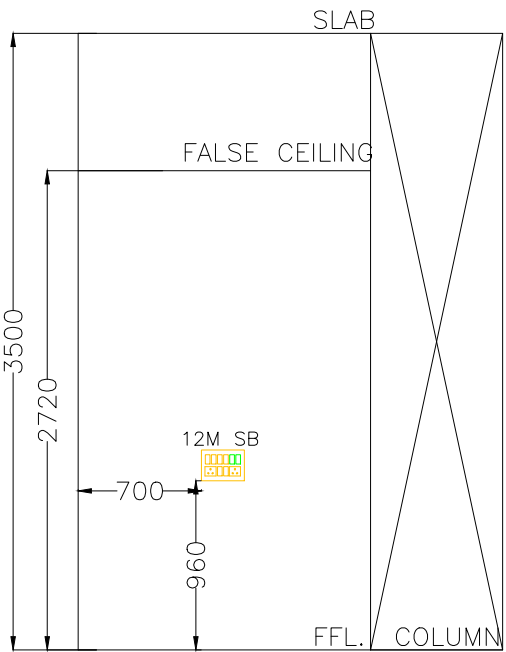


ELEVATION-1

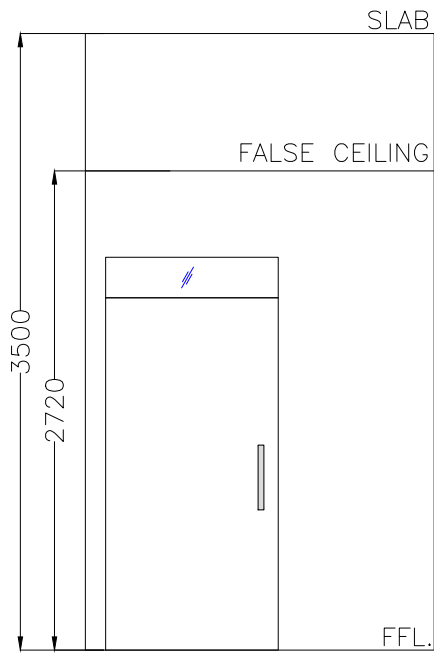


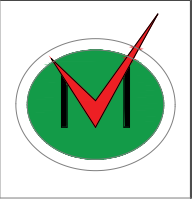
ELEVATION-2

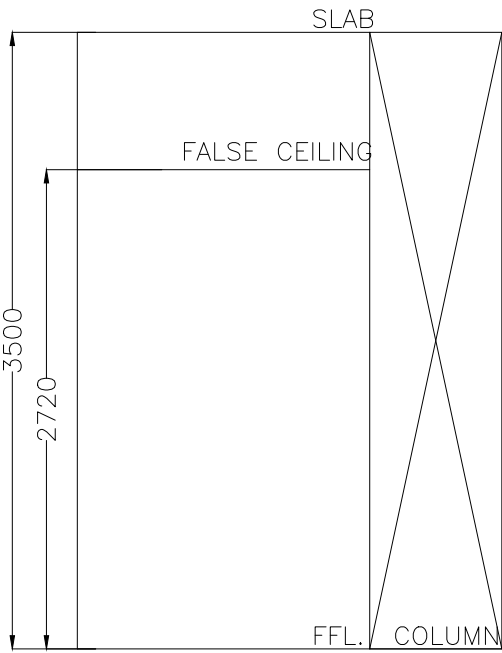

ELEVATION-3

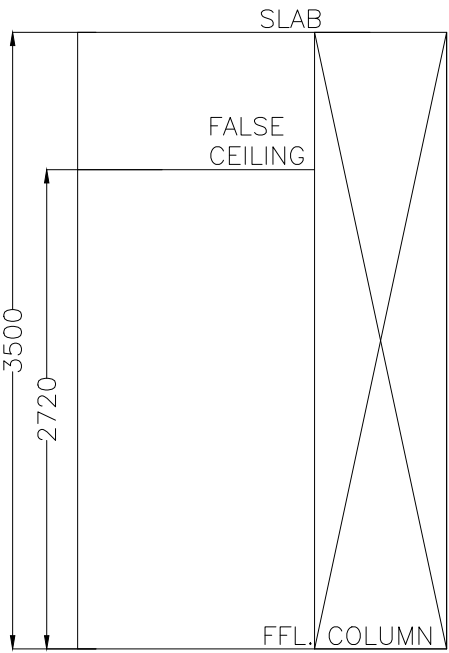

ELEVATION-4

	TITLE :	CLIENT :	PROJECT :						
	RECORD ROOM ELEVATION LAYOUT	TELANGANA STATE MEDICAL SERVICES AND INFRASTRUCTURE DEVELOPMENT CORPORATION.	IFV CENTER ON SECOND FLOOR IN MOTHER & CHILD HOSPITAL BUILDING BESIDE GANDHI HOSPITAL , SECUNDERABAD ,TELANGANA.						
	PURPOSE OF DRAWING :-	DWG. No.:	CONTRACTOR :						
	PROPOSED <input type="checkbox"/> FOR APPROVAL <input type="checkbox"/>	AVC/TGMSIDC/IVFG/S/04	<div><div>M/s Asta Vardhman Consortium H. NO. 8-2-334/27, Plot No. 27, Road No. 03, Banjara Hills, Hyderabad - 500034</div></div>						
	WORKING <input type="checkbox"/> AS BUILT <input checked="" type="checkbox"/>	<table><tr><td>REV</td><td>R4</td><td>DATE</td><td>04-06-2024</td></tr><tr><td>SCALE</td><td>NTS</td><td>SHEET</td><td>16</td></tr></table>		REV	R4	DATE	04-06-2024	SCALE	NTS
REV	R4	DATE	04-06-2024						
SCALE	NTS	SHEET	16						