
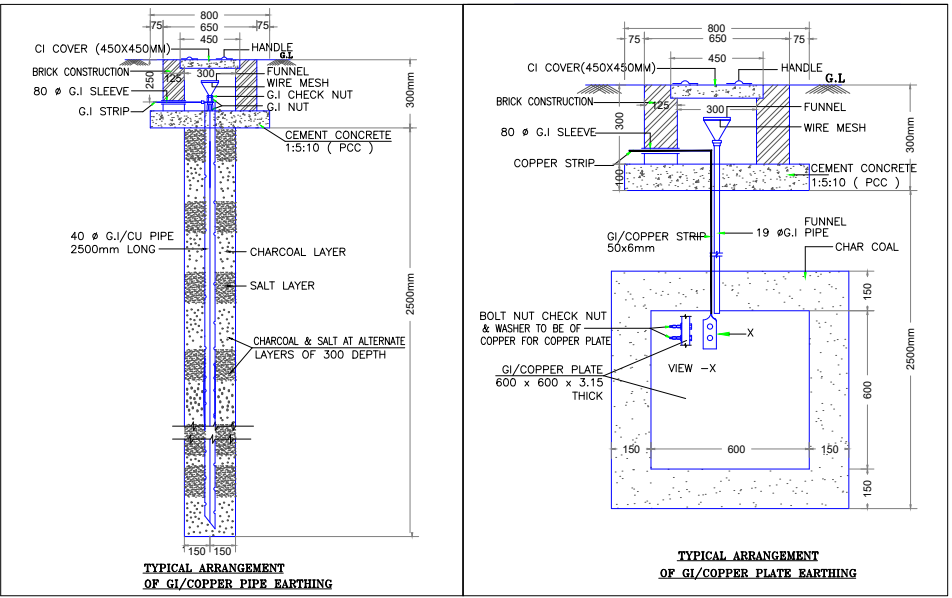


GENERAL BODY EARTHING FOR LT PANELS & DBS

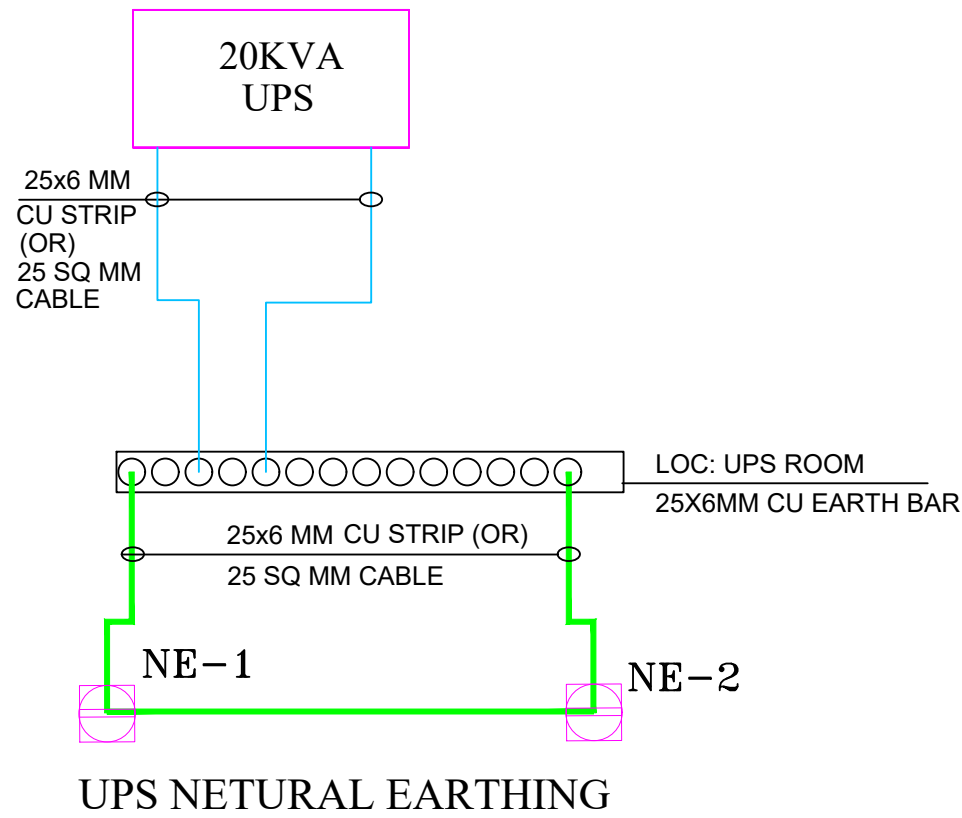

# EARTHING SCHEMATIC LAYOUT

	TITLE :		CLIENT :		PROJECT :	
	EARTHING SCHEMATIC LAYOUT		TELANGANA STATE MEDICAL SERVICES AND INFRASTRUCTURE DEVELOPMENT CORPORATION.		IFV CENTER ON SECOND FLOOR IN MOTHER & CHILD HOSPITAL BUILDING BESIDE GANDHI HOSPITAL , SECUNDERABAD ,TELANGANA.	
	PURPOSE OF DRAWING :-		DWG. No.:		CONTRACTOR :	
	PROPOSED <input type="checkbox"/> FOR APPROVAL <input type="checkbox"/>		AVC/TGMSIDC/IVFG/ELE/04		M/s Asta Vardhman Consortium H. NO. 8-2-334/27, Plot No. 27, Road No. 03, Banjara Hills, Hyderabad - 500034	
WORKING <input type="checkbox"/> AS BUILT <input checked="" type="checkbox"/>		REV	R5	DATE	20-06-2024	
		SCALE	NTS	SHEET	07	