

FALSE CEILING


12M SB


700


FFL. COLUMN

RCP PLAN

ELEVATION-1

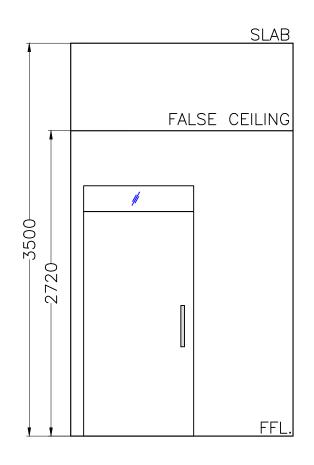

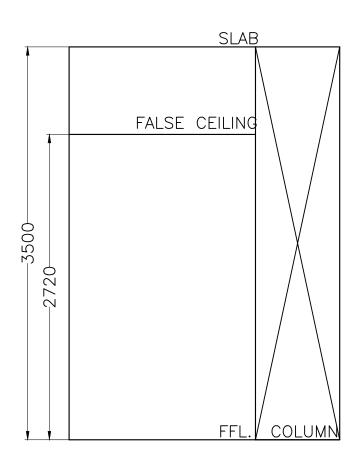


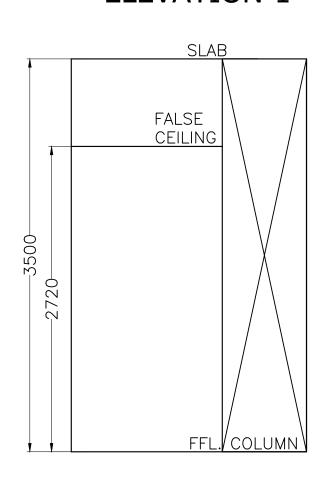

ELEVATION-2

ELEVATION-3

ELEVATION-4

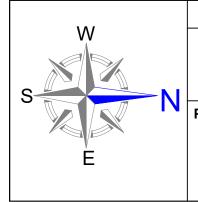

RECORD ROOM ELEVATION LAYOUT

PROPOSED FOR APPROVAL

PURPOSE OF DRAWING :-

WORKING

TITLE:

AS BUILT

CLIENT:

TELANGANA STATE MEDICAL SERVICES AND INFRASTRUCTURE DEVELOPMENT CORPORATION.

DWG. No.:

AVC/TGMSIDC/IVFG/S/04

 REV
 R5
 DATE
 20-06-2024

 SCALE
 NTS
 SHEET
 16

PROJECT:

IFV CENTER ON SECOND FLOOR IN MOTHER & CHILD HOSPITAL BUILDING BESIDE GANDHI HOSPITAL, SECUNDERABAD, TELANGANA.

CONTRACTOR:



M/s Asta Vardhman Consortium H. NO. 8-2-334/27, Plot No. 27, Road No. 03, Banjara Hills, Hyderabad - 500034

