




PLAN

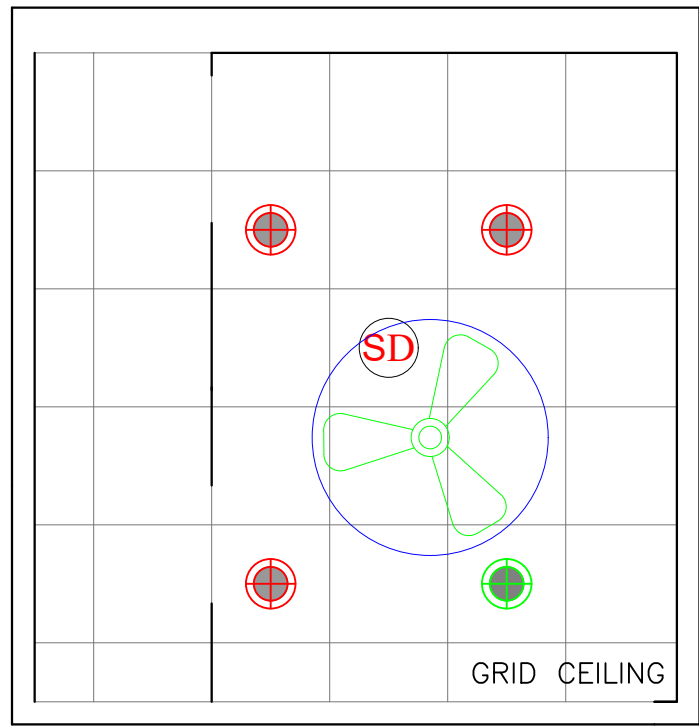


RCP PLAN

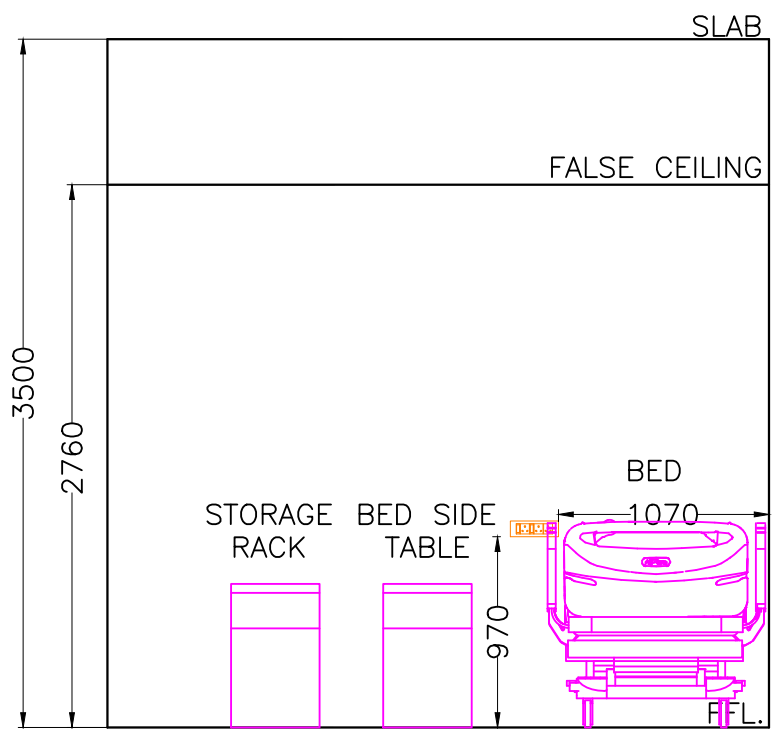


ELEVATION-1

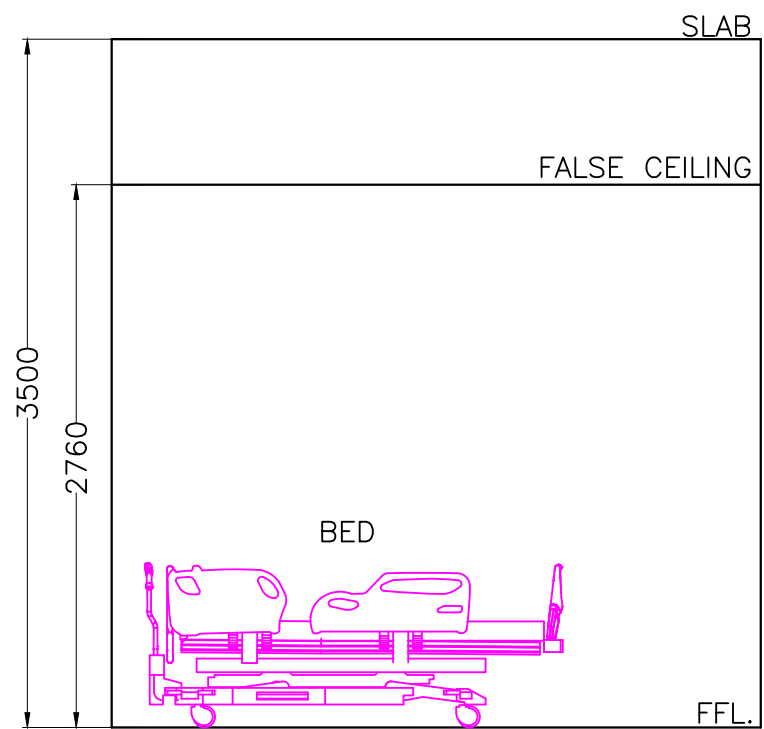


ELEVATION-2

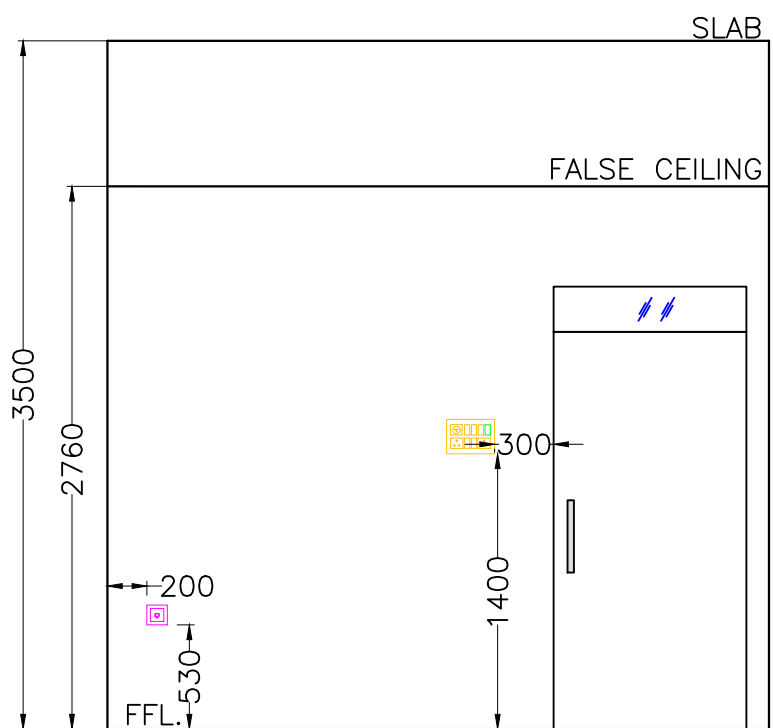

ELEVATION-3

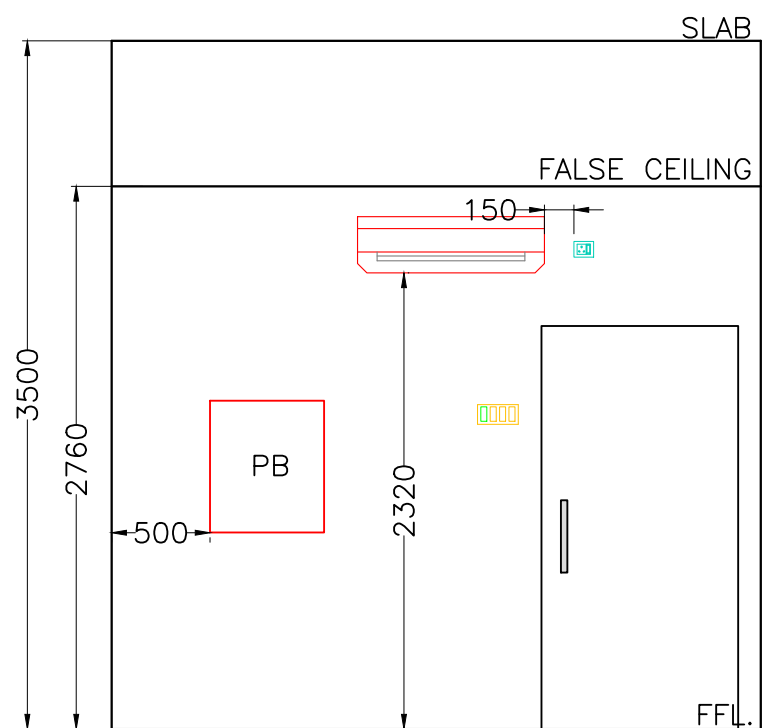

ELEVATION-4

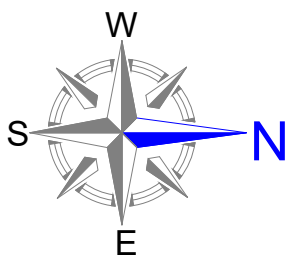

**TITLE :**  
**SEMEN COLLECTION ROOM  
ELEVATION LAYOUT**

**PURPOSE OF DRAWING :-**

**PROPOSED** ☐ **FOR APPROVAL** ☐  
**WORKING** ☐ **AS BUILT** ☒

**CLIENT :**  
TELANGANA STATE MEDICAL  
SERVICES AND INFRASTRUCTURE  
DEVELOPMENT CORPORATION.

DWG. No.:  
AVC/TGMSIDC/IVFG/S/13

REV	R5	DATE	20-06-2024
SCALE	NTS	SHEET	25

**PROJECT :**  
IFV CENTER ON SECOND FLOOR IN  
MOTHER & CHILD HOSPITAL BUILDING  
BESIDE GANDHI HOSPITAL ,  
SECUNDERABAD ,TELANGANA.

**CONTRACTOR :**



M/s Asta Vardhman Consortium  
H. NO. 8-2-334/27, Plot No. 27,  
Road No. 03, Banjara Hills,  
Hyderabad - 500034

