




PLAN

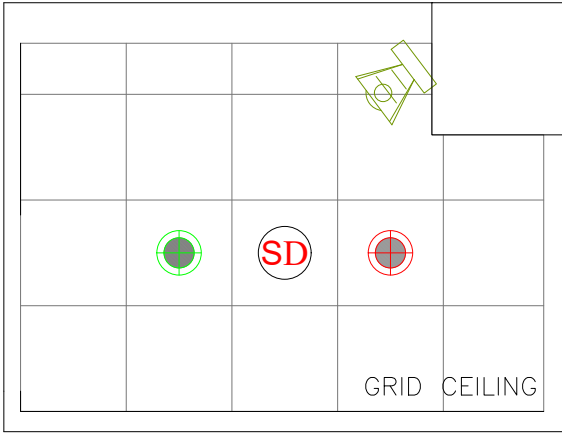


RCP PLAN

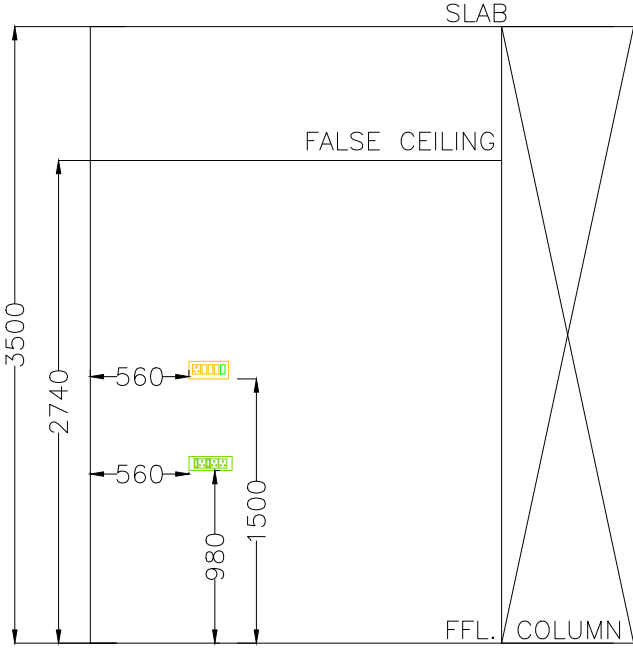


ELEVATION-1

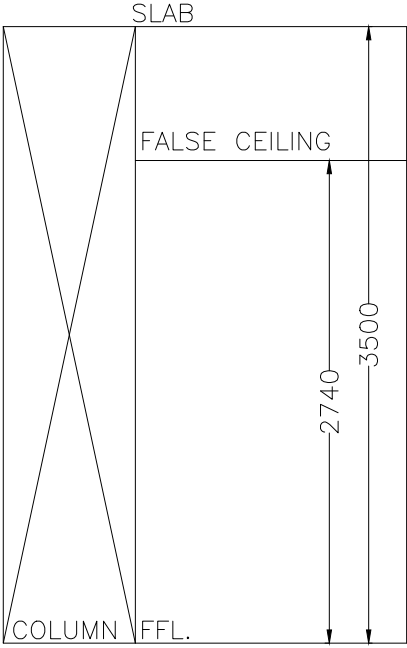

ELEVATION-2

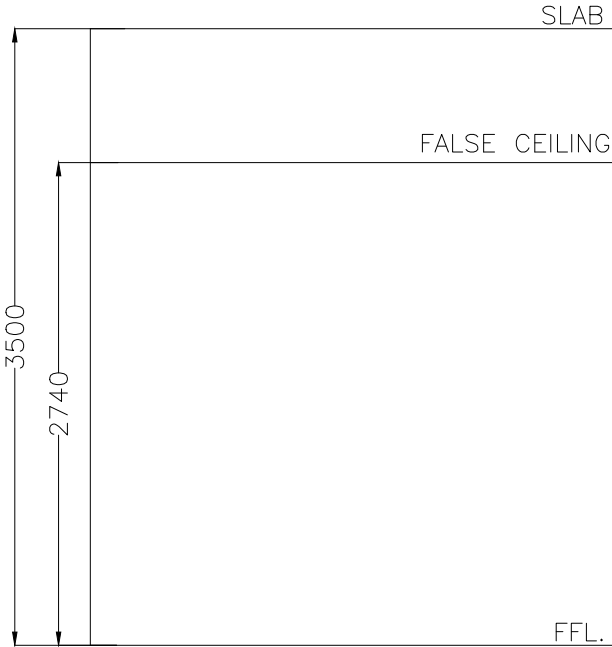

ELEVATION-3

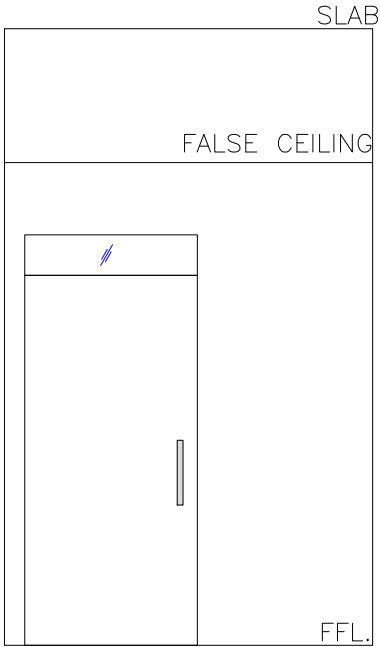

ELEVATION-4

	TITLE :	CLIENT :	PROJECT :							
	STORE ROOM ELEVATION LAYOUT	TELANGANA STATE MEDICAL SERVICES AND INFRASTRUCTURE DEVELOPMENT CORPORATION.	IFV CENTER ON SECOND FLOOR IN MOTHER & CHILD HOSPITAL BUILDING BESIDE GANDHI HOSPITAL , SECUNDERABAD ,TELANGANA.							
	PURPOSE OF DRAWING :-	DWG. No.:	CONTRACTOR :							
	<div>PROPOSED <input type="checkbox"/> FOR APPROVAL <input type="checkbox"/></div> <div>WORKING <input type="checkbox"/> AS BUILT <input checked="" type="checkbox"/></div>	<div>AVC/TGMSIDC/IVFG/S/08</div> <table><tr><td>REV</td><td>R4</td><td>DATE</td><td>04-06-2024</td></tr><tr><td>SCALE</td><td>NTS</td><td>SHEET</td><td>20</td></tr></table>	REV	R4	DATE	04-06-2024	SCALE	NTS	SHEET	20
REV	R4	DATE	04-06-2024							
SCALE	NTS	SHEET	20							