




PLAN

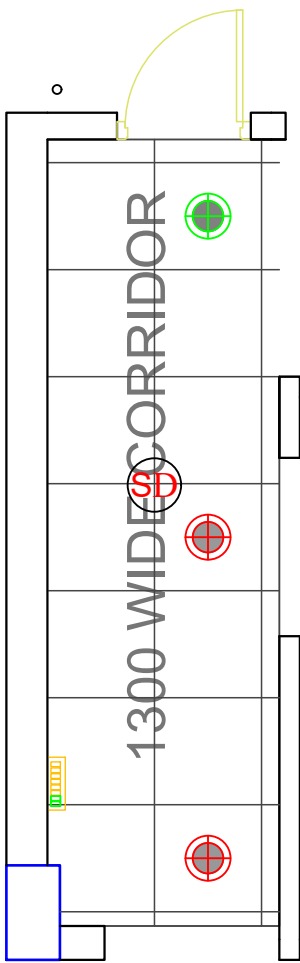


RCP

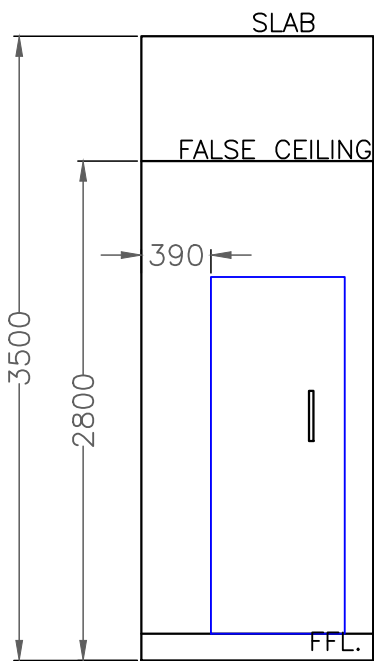


ELEVATION-1

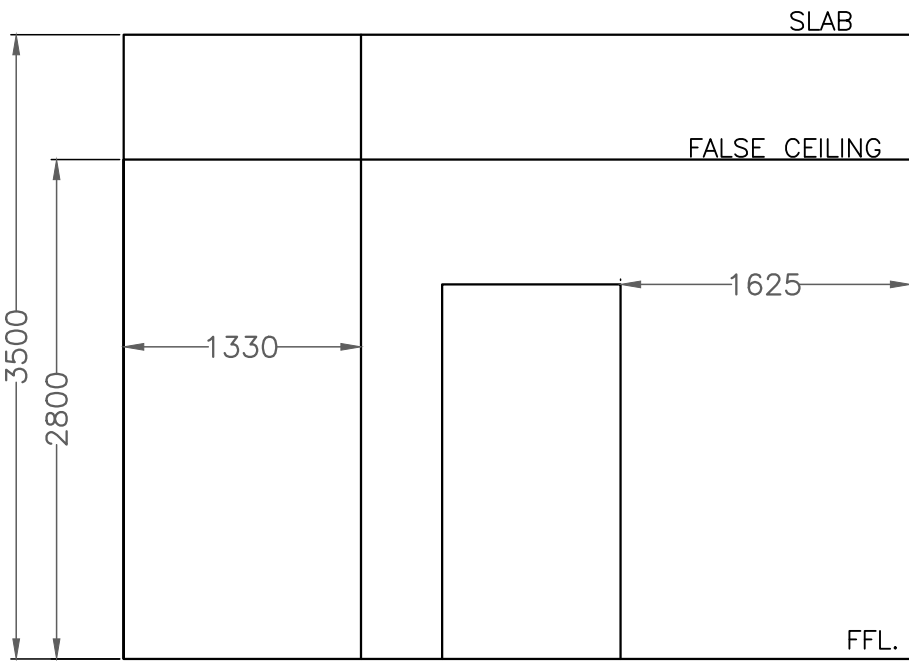

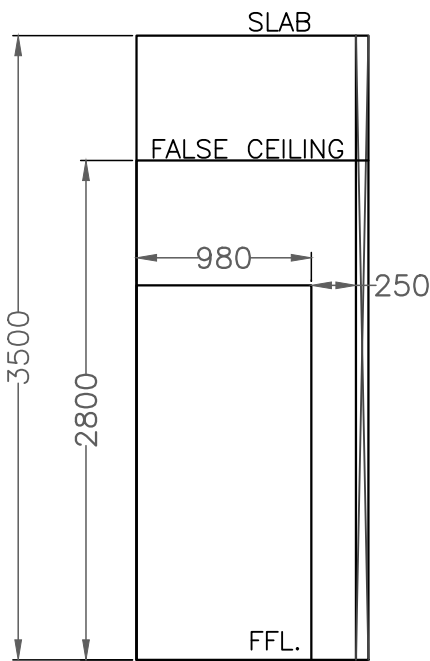

ELEVATION-2

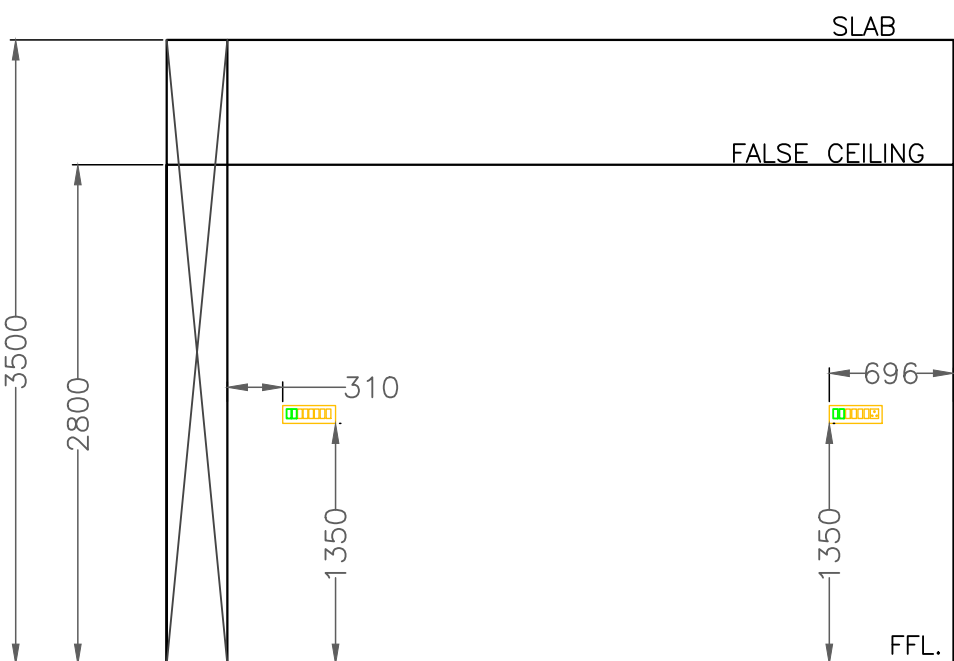

ELEVATION-3



ELEVATION-4

	TITLE :		CLIENT :		PROJECT :		
	DR CHANGE ROOMS CORRIDOR ELEVATION LAYOUT		TELANGANA STATE MEDICAL SERVICES AND INFRASTRUCTURE DEVELOPMENT CORPORATION.		IFV CENTER ON THIRD FLOOR IN MODERN GOVERNMENT MATERNITY HOSPITAL, PETLABURJ, HYDERABAD ,TELANGANA.		
PURPOSE OF DRAWING :-		DWG. No.:		CONTRACTOR :			
PROPOSED <input type="checkbox"/> FOR APPROVAL <input type="checkbox"/>		AVC/TGMSIDC/IVFP/S/05		<div><div>M/s Asta Vardhman Consortium H. NO. 8-2-334/27, Plot No. 27, Road No. 03, Banjara Hills, Hyderabad - 500034</div></div>			
WORKING <input type="checkbox"/> AS BUILT <input checked="" type="checkbox"/>		REV	R2			DATE	20-06-2024
		SCALE	NTS			SHEET	05