




PLAN

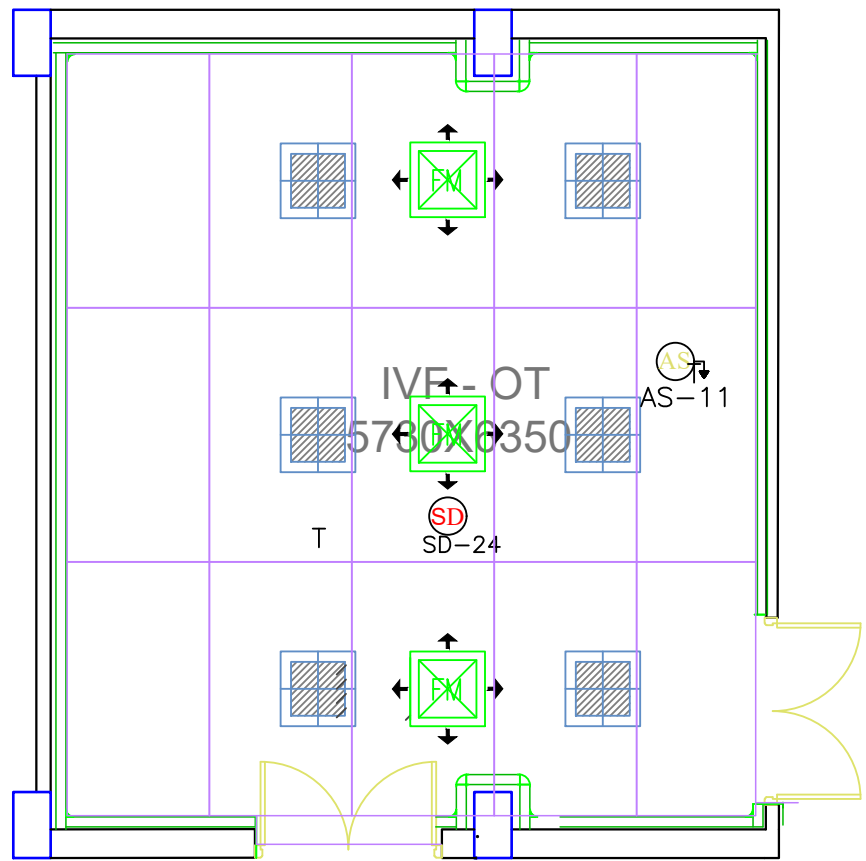


RCP

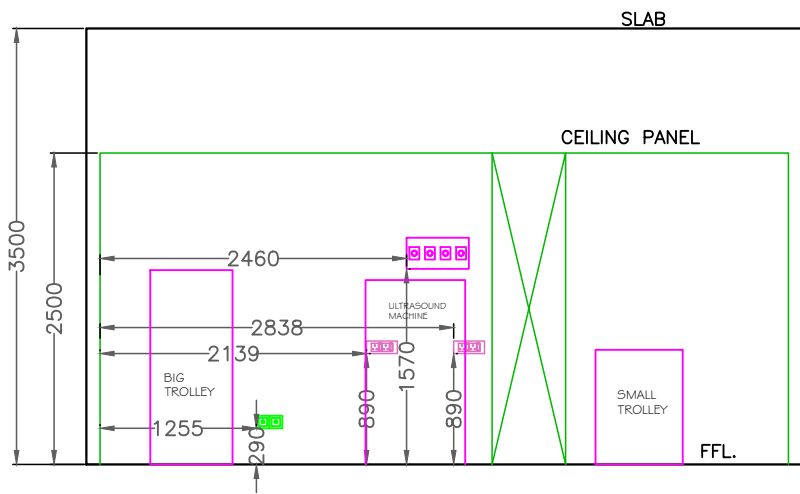


ELEVATION-1

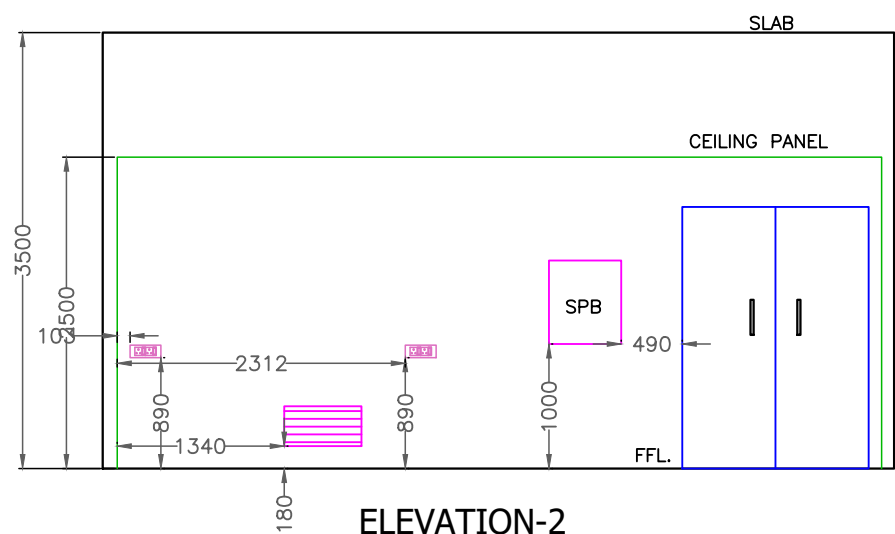


ELEVATION-2

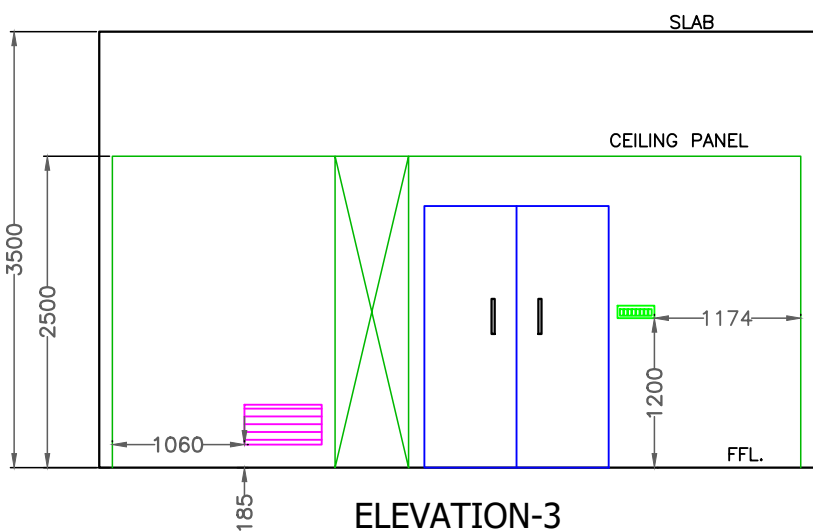

ELEVATION-3

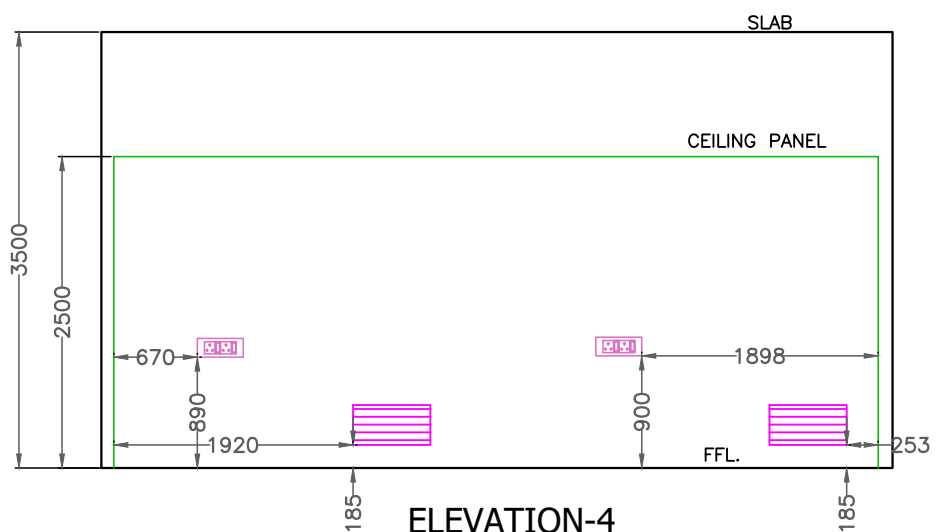

ELEVATION-4

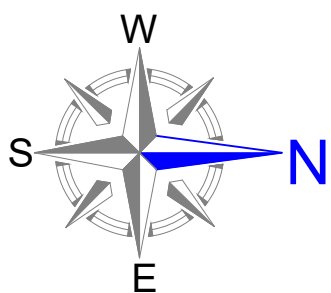

TITLE :

IVF-OT ELEVATION
LAYOUT

PURPOSE OF DRAWING :-

PROPOSED ☐ FOR APPROVAL ☐
WORKING ☐ AS BUILT ☒

CLIENT :

TELANGANA STATE MEDICAL
SERVICES AND INFRASTRUCTURE
DEVELOPMENT CORPORATION.

DWG. No.:

AVC/TGMSIDC/IVFP/S/15

REV	R2	DATE	20-06-2024
SCALE	NTS	SHEET	15

PROJECT :

IFV CENTER ON THIRD FLOOR IN MODERN
GOVERNMENT MATERNITY HOSPITAL,
PETLABURJ, HYDERABAD ,TELANGANA.

CONTRACTOR :



M/s Asta Vardhman Consortium
H. NO. 8-2-334/27, Plot No. 27,
Road No. 03, Banjara Hills,
Hyderabad - 500034

