



LEGEND:




UNCC

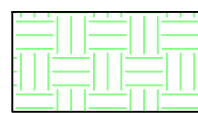

GRADE-C

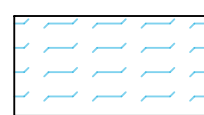

UNCUC


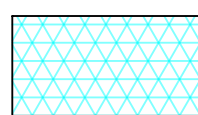


GRADE-B



GRADE-D

CLASSIFICATION ZONING LAYOUT

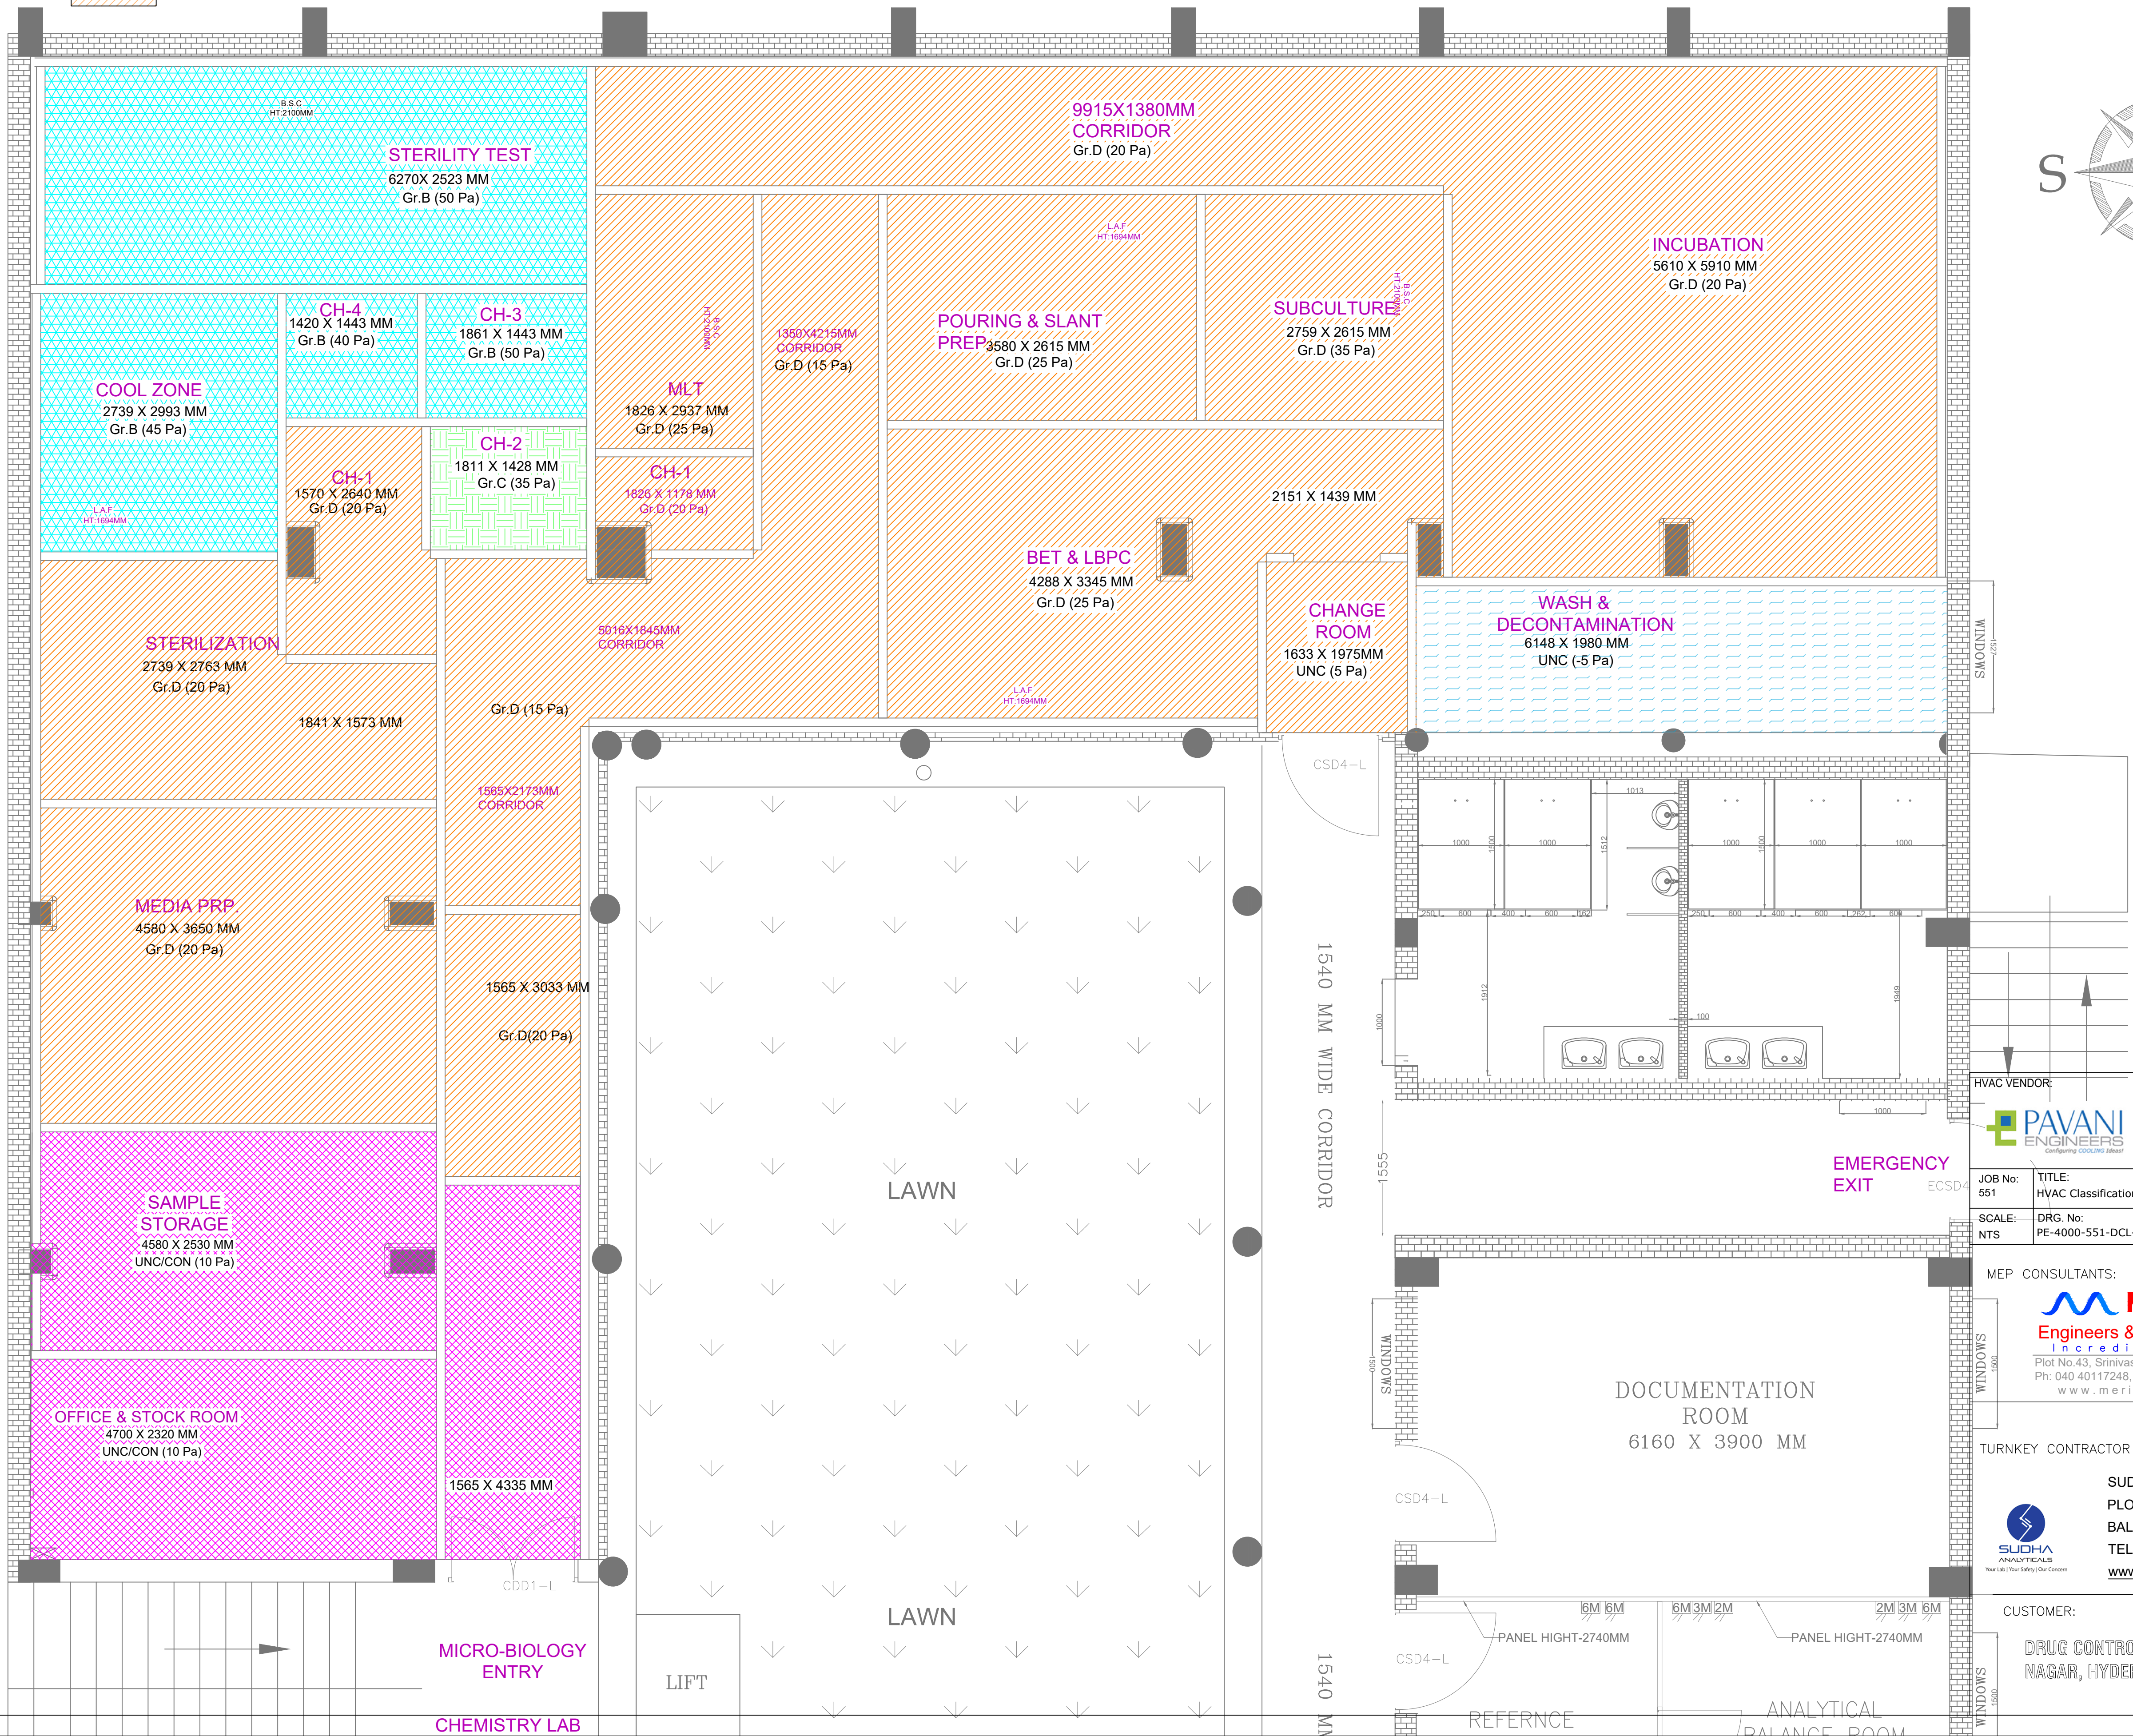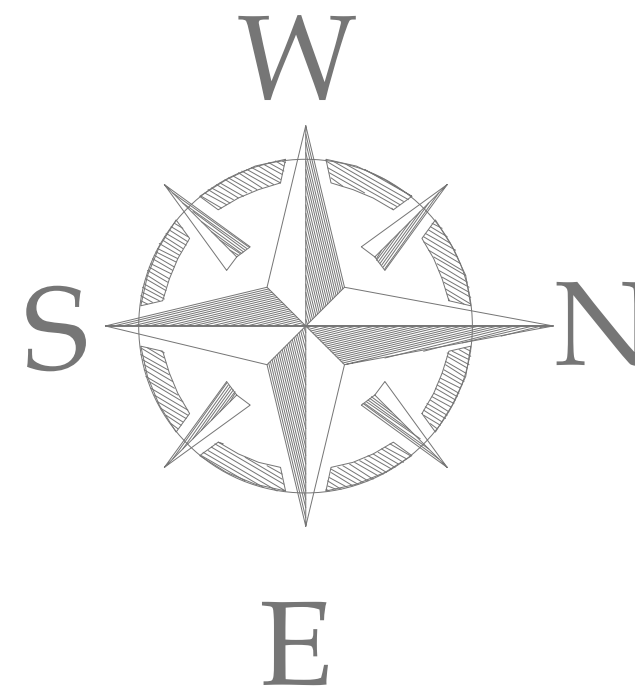

AS BUILT

HVAC VENDOR:

PAVANI ENGINEERS
Configuring COOLING Ideas!

PLOT NO. 26, IDA MALLAPUR, NACHARAM,
HYDERABAD-500 076.
Ph: 040-27176661, 27176662, 27176663
E-mail: Pavaniengineers@gmail.com

JOB No: 551
SCALE: NTS

TITLE: HVAC Classification Zoning Layout - Microbiology, First Floor, DCL.
DRG. No: PE-4000-551-DCL-HVAC-CZL-AB

MEP CONSULTANTS:

MERIDIAN
Engineers & Consultancy Services
Incredible innovation
Plot No.43, Srinivasa Colony (West), Hyderabad 500 038
Ph: 040 40117248, E Mail : contact@meridianmep.com
www.meridianmep.com

TURNKEY CONTRACTOR

SUDHA ANALYTICALS
Real Lab's Near Safety Color Concern

SUDHA ANALYTICALS. SY. NO. 118,
PLOT NO. 18 PART, IDA BALANAGAR,
BALANAGAR, HYDERABAD - 500037
TEL (+91) 40 23810902 / 906
www.sudhaanalytics.com

CUSTOMER:

DRUG CONTROL LABORATORY, VENGALRAO NAGAR, HYDERABAD