




PLAN

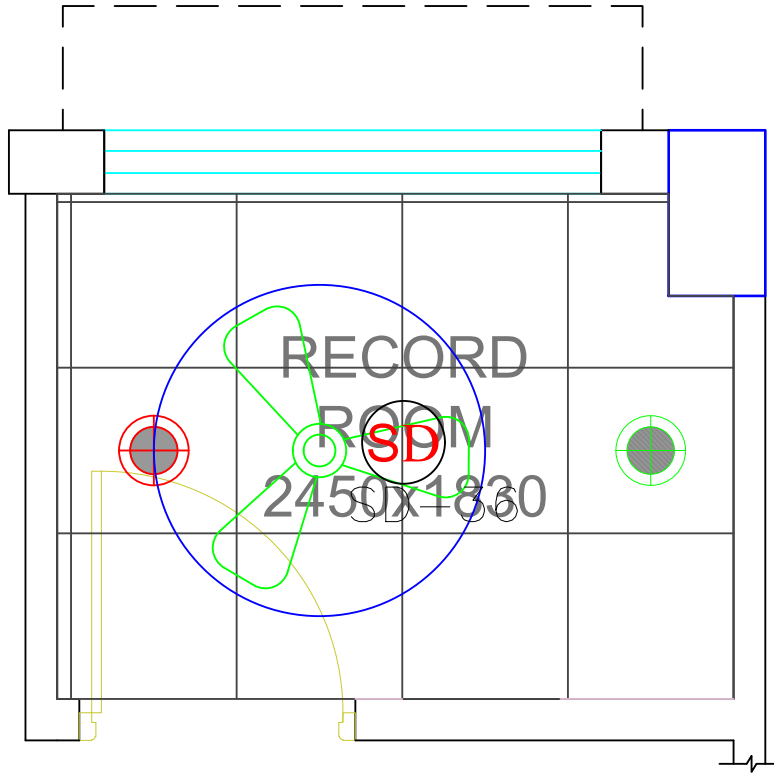


RCP

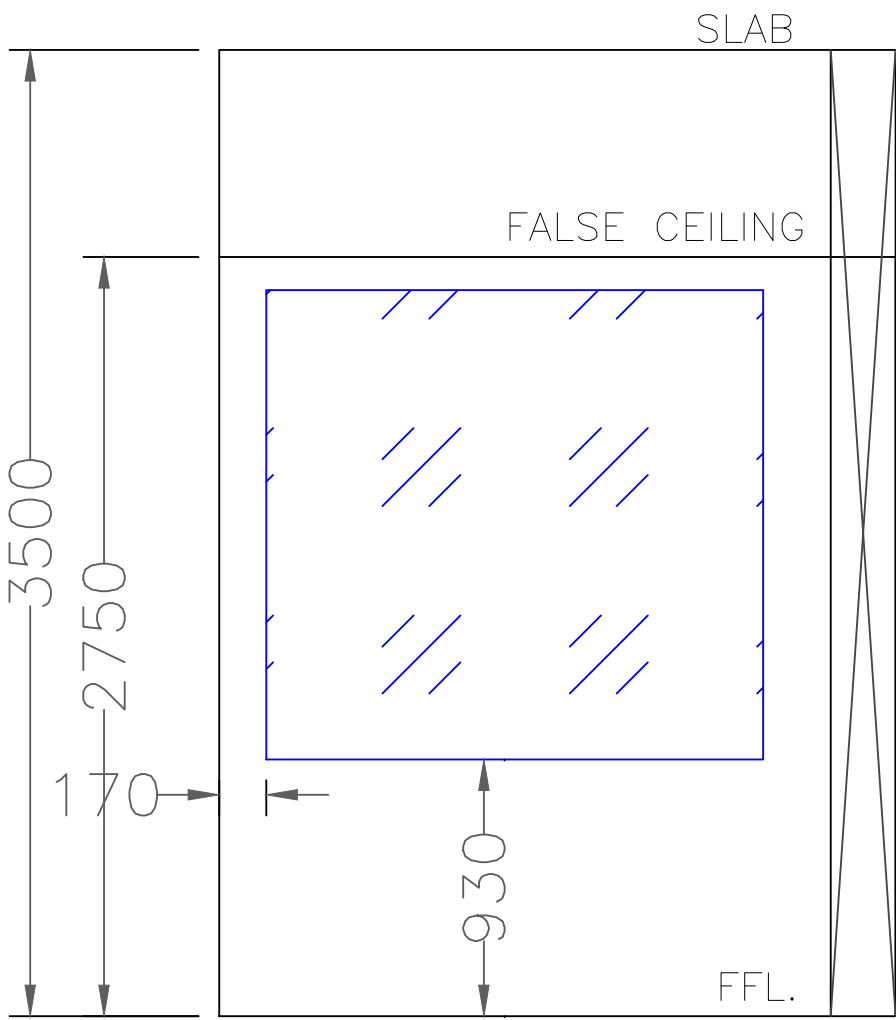


ELEVATION-1

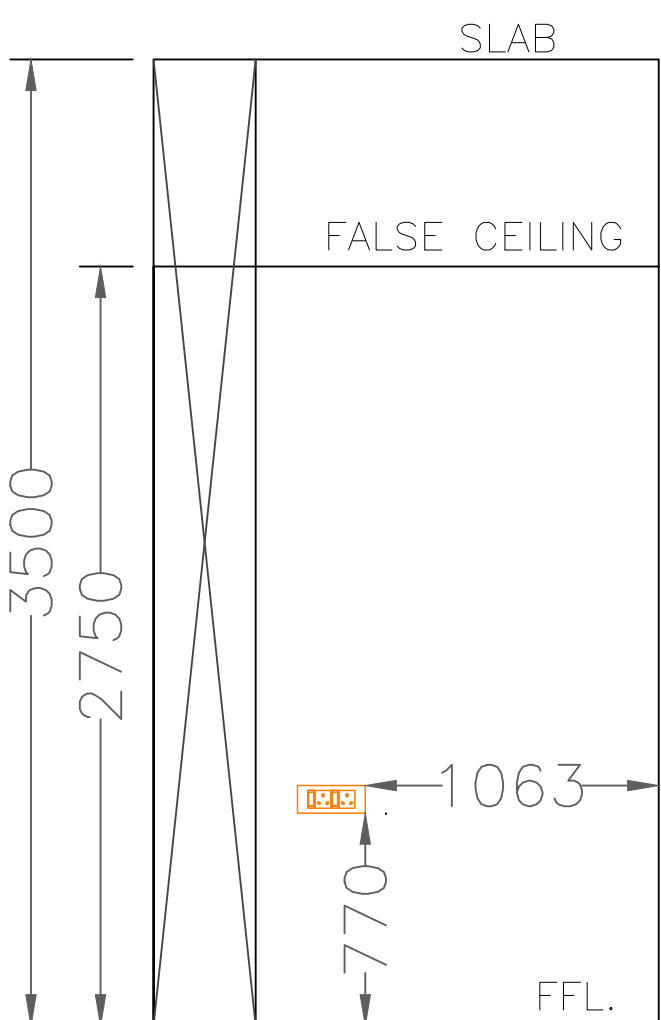


ELEVATION-2

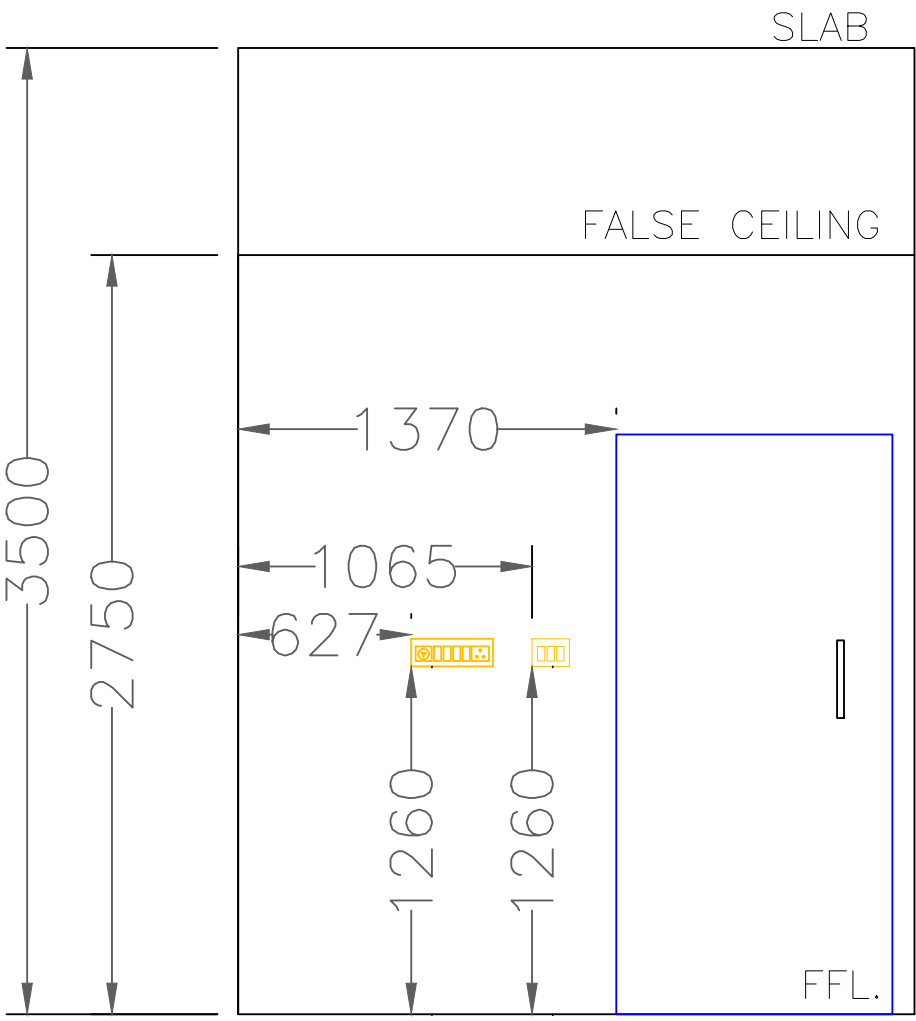

ELEVATION-3

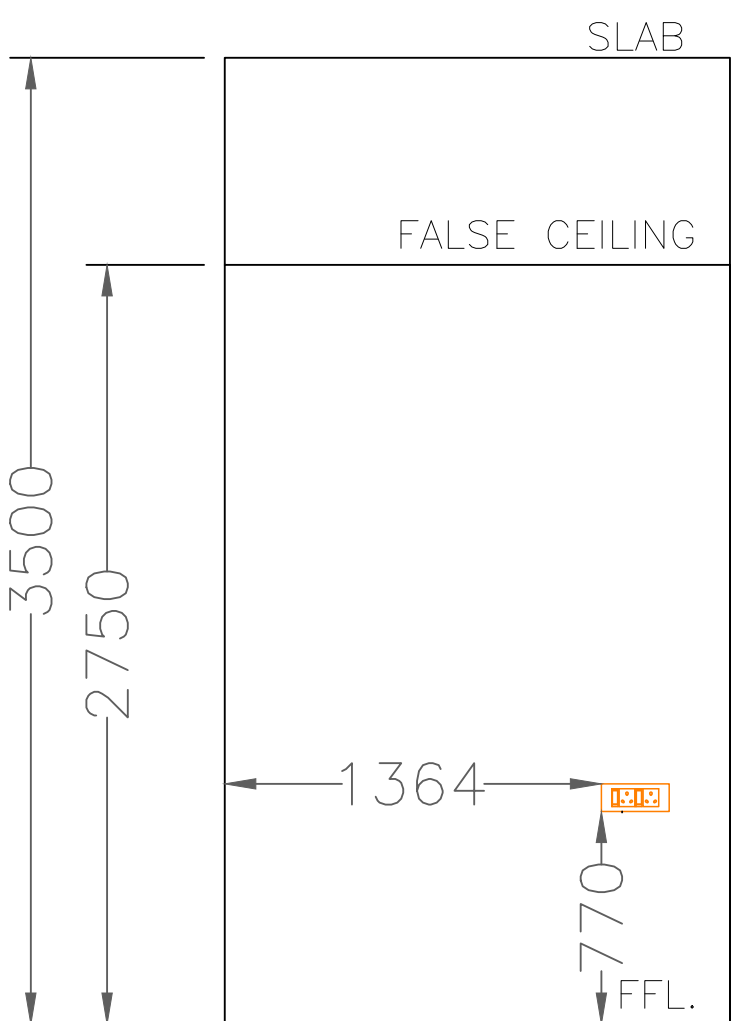

ELEVATION-4

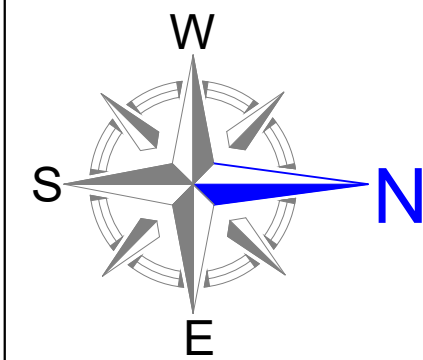

	TITLE :	CLIENT :	PROJECT :
	RECORD ROOM ELEVATION LAYOUT	TELANGANA STATE MEDICAL SERVICES AND INFRASTRUCTURE DEVELOPMENT CORPORATION.	IFV CENTER ON THIRD FLOOR IN MODERN GOVERNMENT MATERNITY HOSPITAL, PETLABURJ, HYDERABAD ,TELANGANA.
	PURPOSE OF DRAWING :-	DWG. No.:	CONTRACTOR :
	PROPOSED <input type="checkbox"/> FOR APPROVAL <input type="checkbox"/>	AVC/TGMSIDC/IVFP/S/03	 M/s Asta Vardhman Consortium H. NO. 8-2-334/27, Plot No. 27, Road No. 03, Banjara Hills, Hyderabad - 500034
	WORKING <input type="checkbox"/> AS BUILT <input checked="" type="checkbox"/>	REV R1 DATE 17-06-2024	
		SCALE NTS SHEET 03	