




PLAN

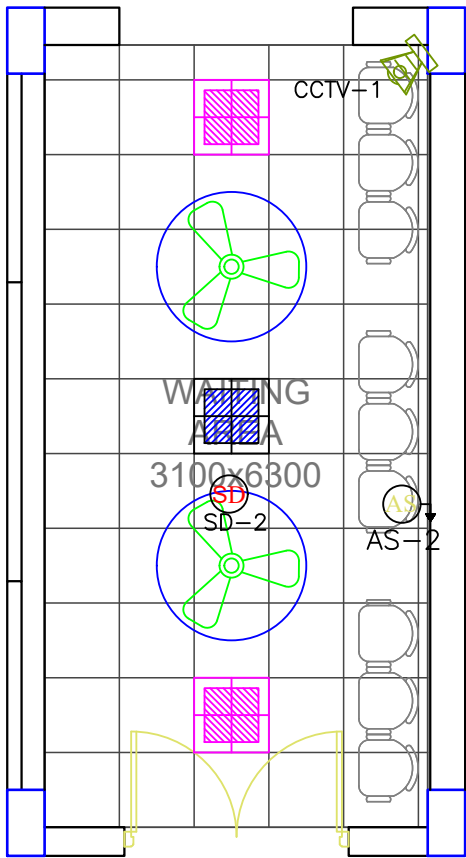


RCP

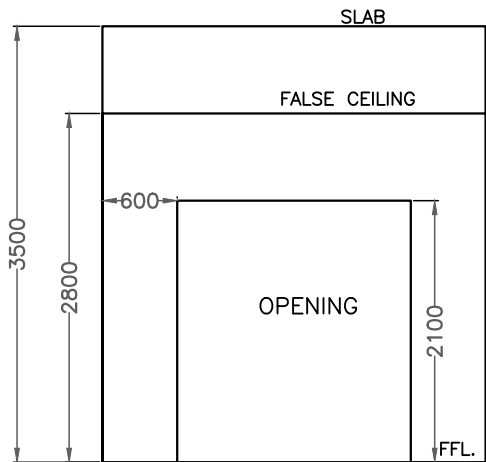


ELEVATION-1

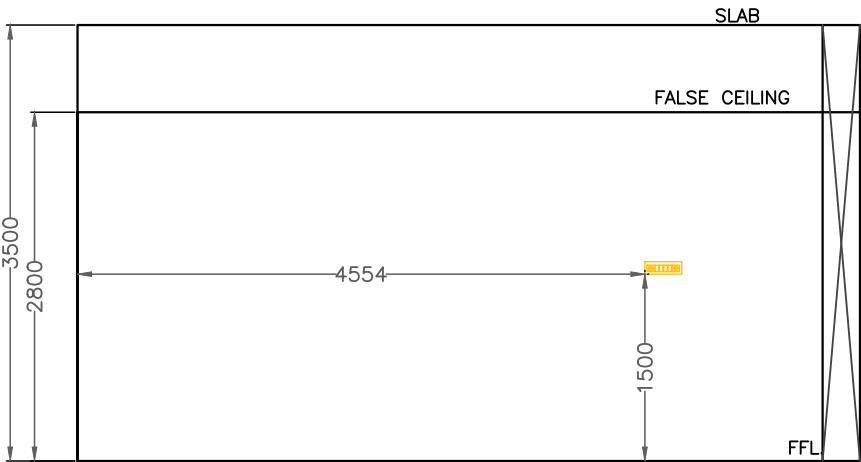


ELEVATION-2

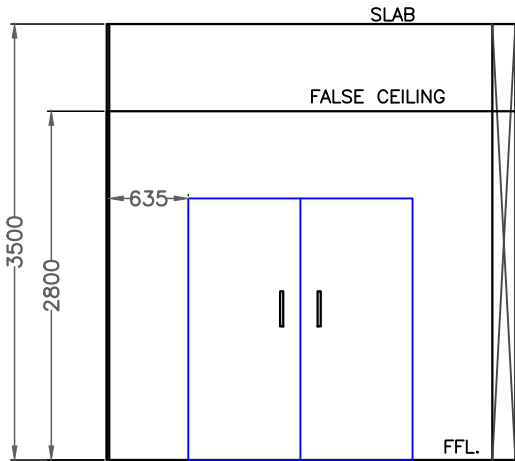

ELEVATION-3

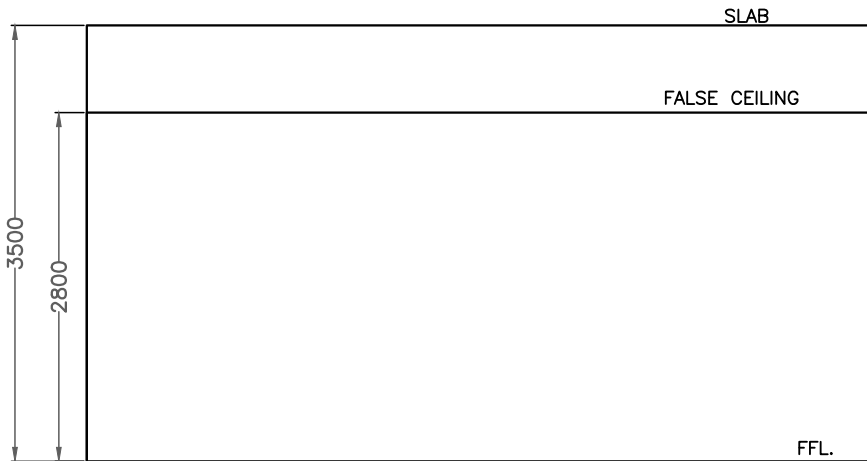

ELEVATION-4

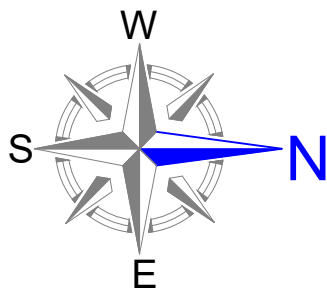

TITLE :

WAITING AREA  
ELEVATION LAYOUT

PURPOSE OF DRAWING :-

PROPOSED ☐ FOR APPROVAL ☐  
WORKING ☐ AS BUILT ☒

CLIENT :

TELANGANA STATE MEDICAL  
SERVICES AND INFRASTRUCTURE  
DEVELOPMENT CORPORATION.

DWG. No.:

AVC/TGMSIDC/IVFP/S/02

REV	R2	DATE	20-06-2024
SCALE	NTS	SHEET	02

PROJECT :

IFV CENTER ON THIRD FLOOR IN MODERN  
GOVERNMENT MATERNITY HOSPITAL,  
PETLABURJ, HYDERABAD ,TELANGANA.

CONTRACTOR :



M/s Asta Vardhman Consortium  
H. NO. 8-2-334/27, Plot No. 27,  
Road No. 03, Banjara Hills,  
Hyderabad - 500034

