




PLAN

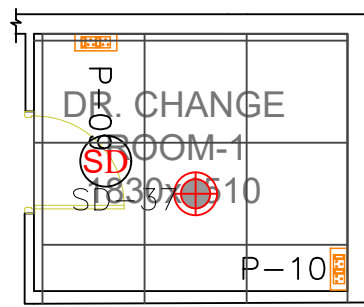


RCP

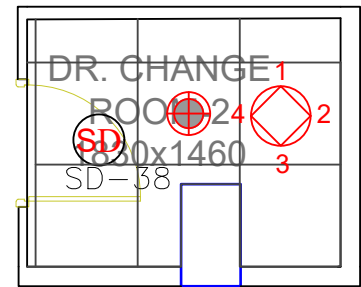


PLAN

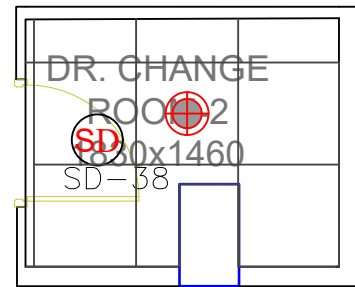


RCP

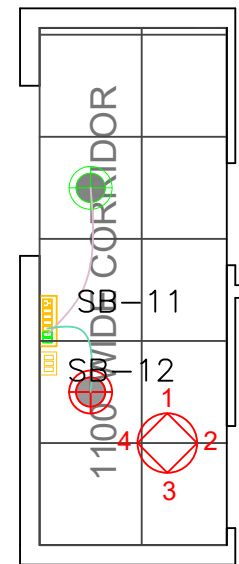


PLAN

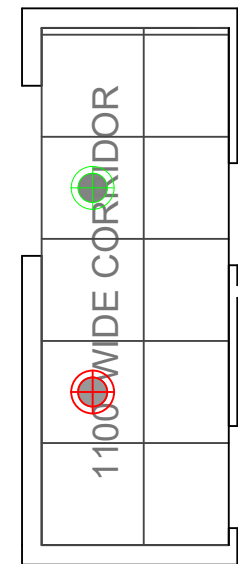


RCP

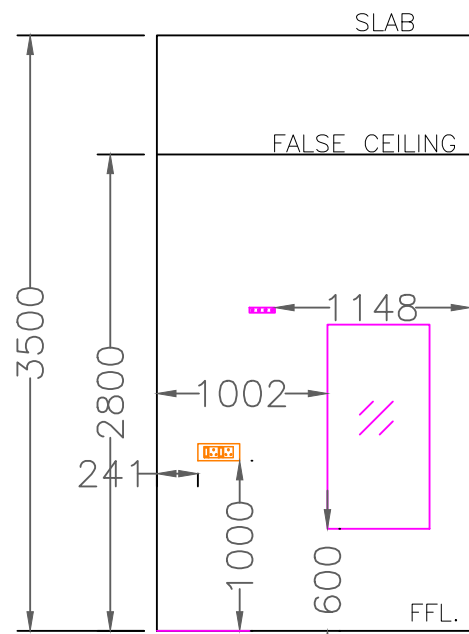


ELEVATION-1

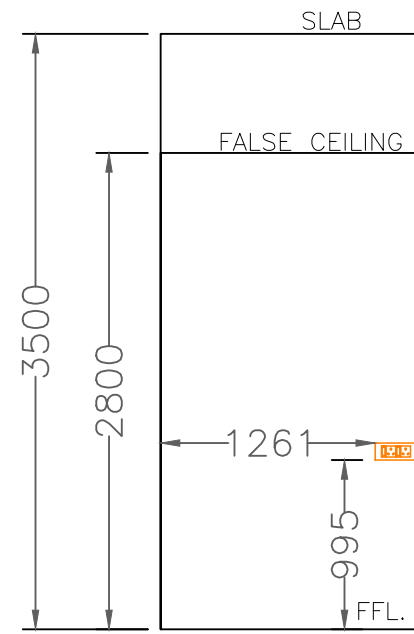


ELEVATION-2

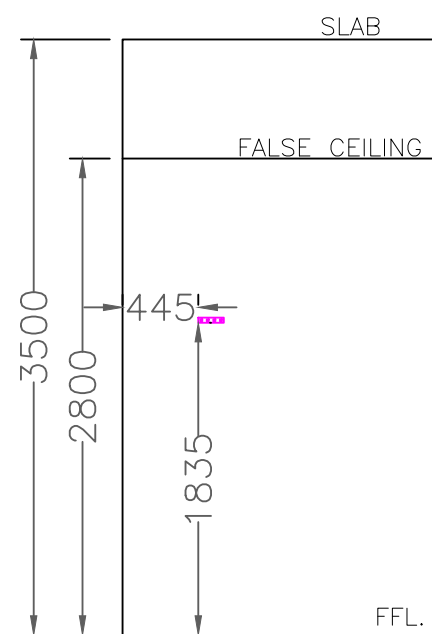


ELEVATION-1

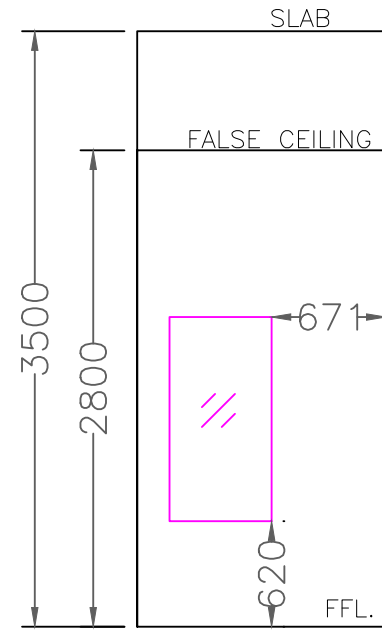


ELEVATION-2

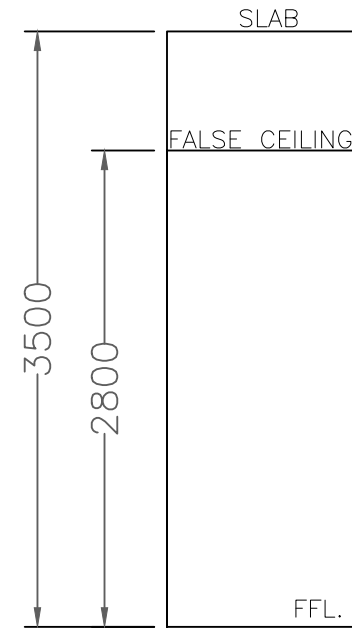


ELEVATION-1

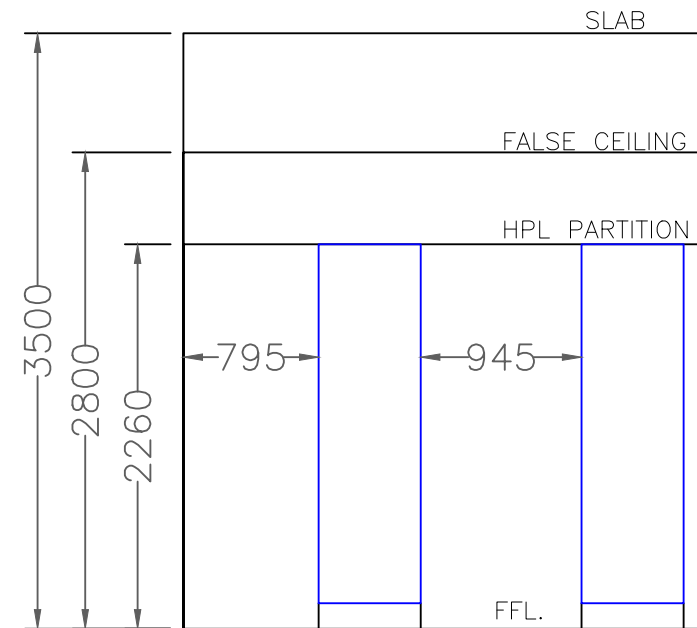


ELEVATION-2

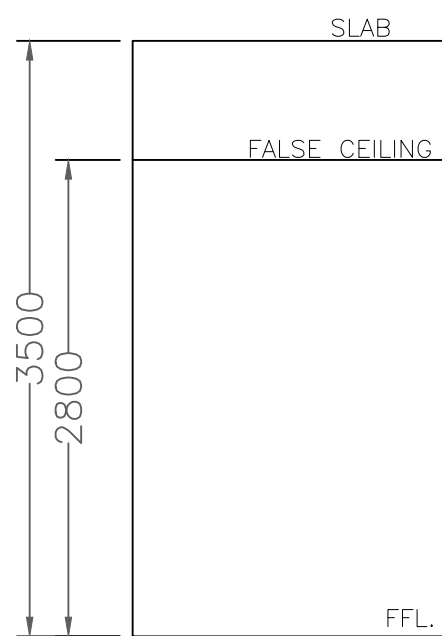


ELEVATION-3

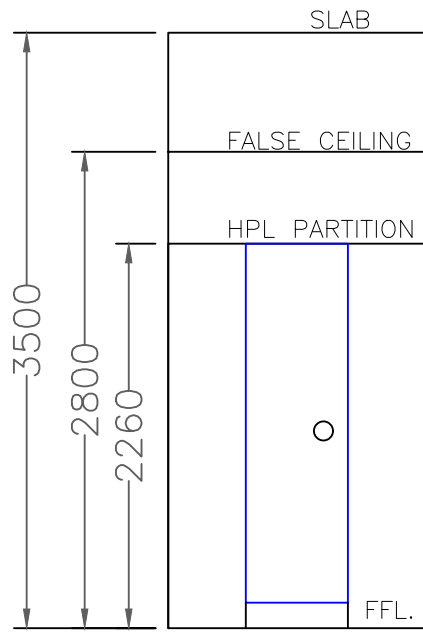


ELEVATION-4

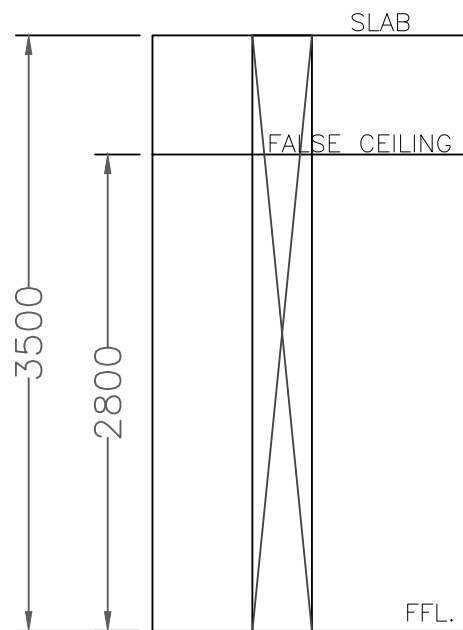


ELEVATION-3

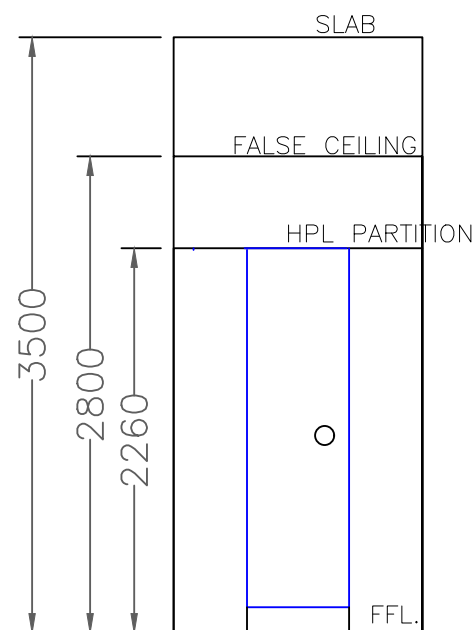

ELEVATION-4

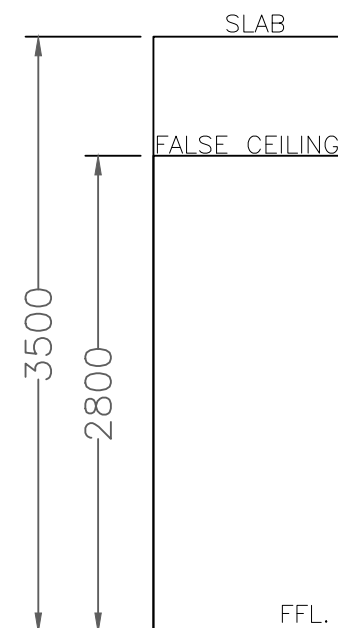

ELEVATION-3

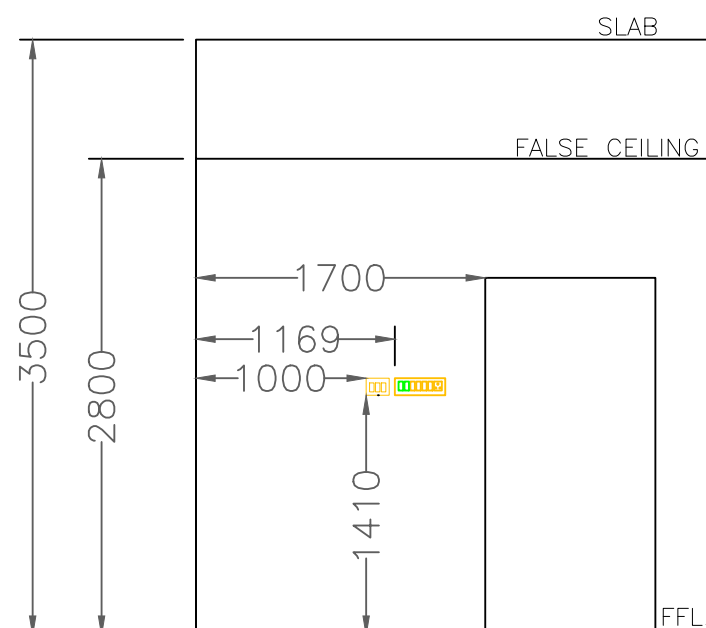


ELEVATION-4

DR CHANGE ROOM-1

DR CHANGE ROOM-2

CHANGE ROOM PASSAGE

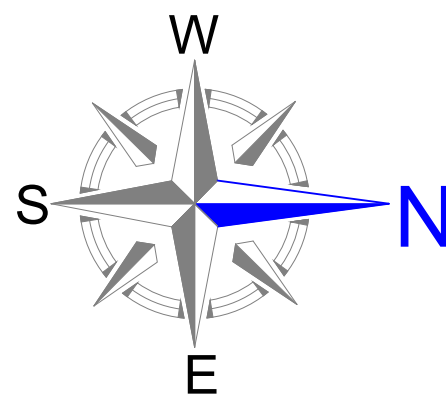

TITLE :

DR CHANGE ROOMS  
ELEVATION LAYOUT

PURPOSE OF DRAWING :-

PROPOSED ☐ FOR APPROVAL ☐

WORKING ☐ AS BUILT ☒

CLIENT :

TELANGANA STATE MEDICAL  
SERVICES AND INFRASTRUCTURE  
DEVELOPMENT CORPORATION.

DWG. No.:

AVC/TGMSIDC/IVFP/S/06

REV

R1

DATE

17-06-2024

SCALE

NTS

SHEET

06

PROJECT :

IFV CENTER ON SECOND FLOOR IN  
MOTHER & CHILD HOSPITAL BUILDING  
BESIDE GANDHI HOSPITAL ,  
SECUNDERABAD ,TELANGANA.

CONTRACTOR :



M/s Asta Vardhman Consortium  
H. NO. 8-2-334/27, Plot No. 27,  
Road No. 03, Banjara Hills,  
Hyderabad - 500034

