




PLAN

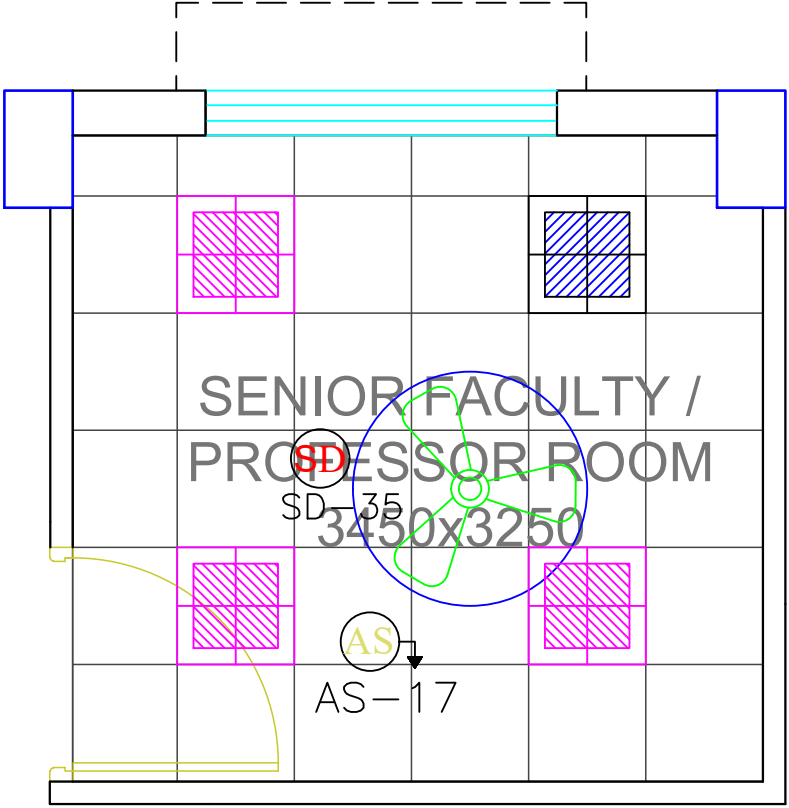


RCP

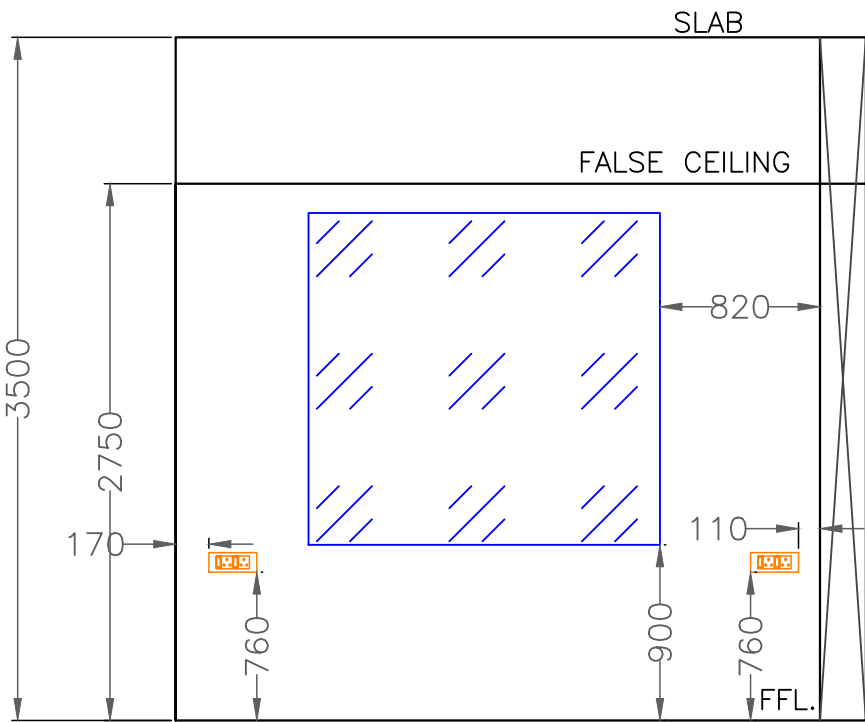


ELEVATION-1

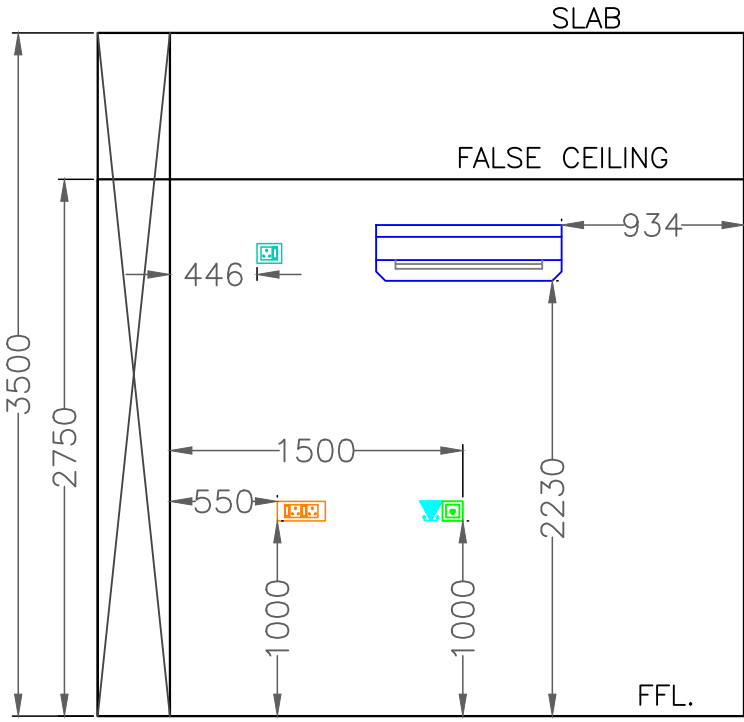

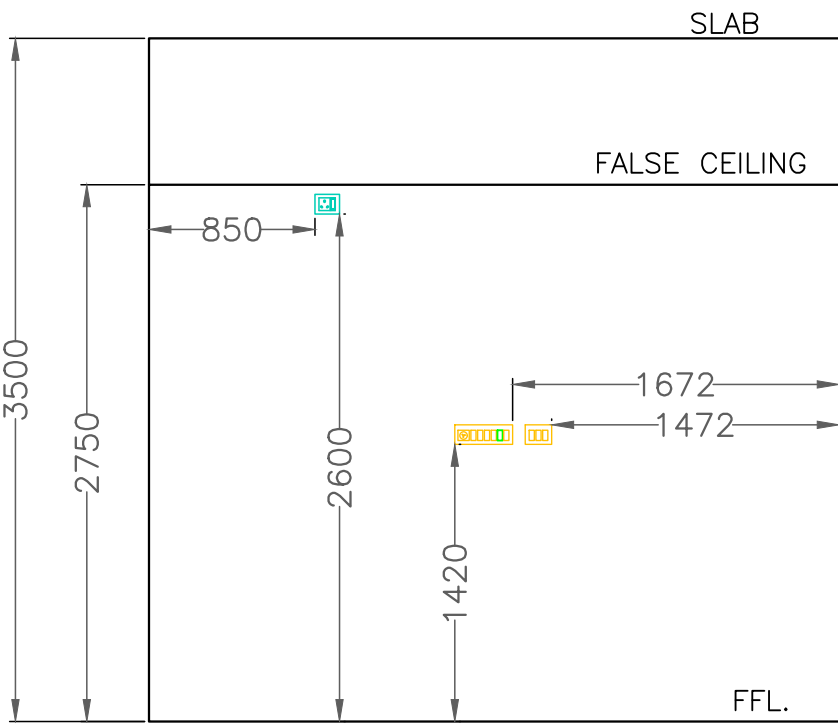


ELEVATION-2

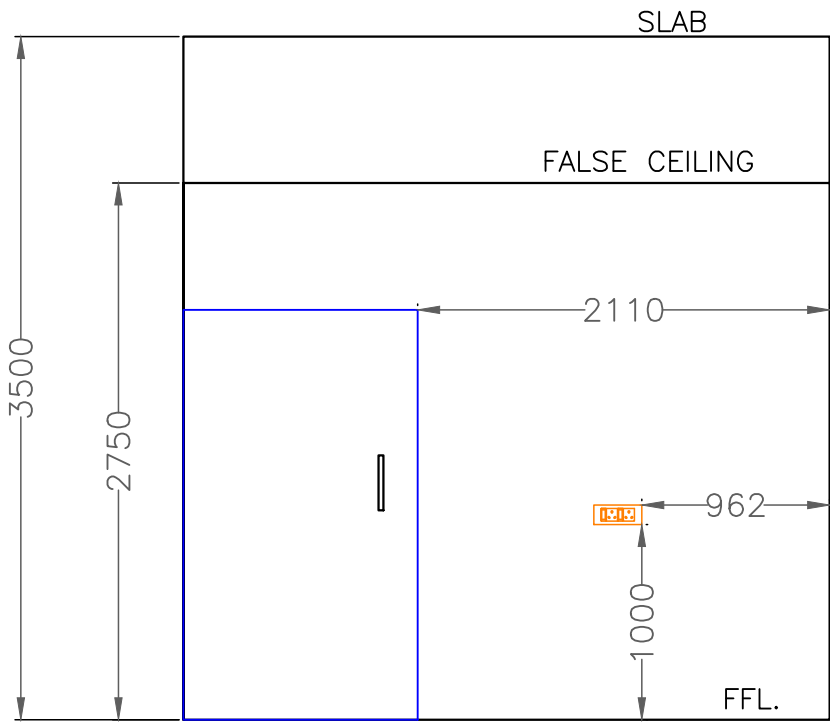

ELEVATION-3

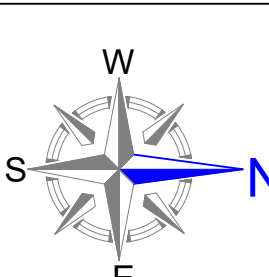

ELEVATION-4

	TITLE :	CLIENT :		PROJECT :	
	SR FACULTY ROOM ELEVATION LAYOUT	TELANGANA STATE MEDICAL SERVICES AND INFRASTRUCTURE DEVELOPMENT CORPORATION.		IFV CENTER ON THIRD FLOOR IN MODERN GOVERNMENT MATERNITY HOSPITAL, PETLABURJ, HYDERABAD ,TELANGANA.	
	PURPOSE OF DRAWING :-	DWG. No.:		CONTRACTOR :	
	PROPOSED <input type="checkbox"/> FOR APPROVAL <input type="checkbox"/>	AVC/TGMSIDC/IVFP/S/04		<div><div>M/s Asta Vardhman Consortium H. NO. 8-2-334/27, Plot No. 27, Road No. 03, Banjara Hills, Hyderabad - 500034</div></div> <div></div>	
	WORKING <input type="checkbox"/> AS BUILT <input checked="" type="checkbox"/>	REV	R2		
	SCALE	NTS	SHEET	4	