




PLAN

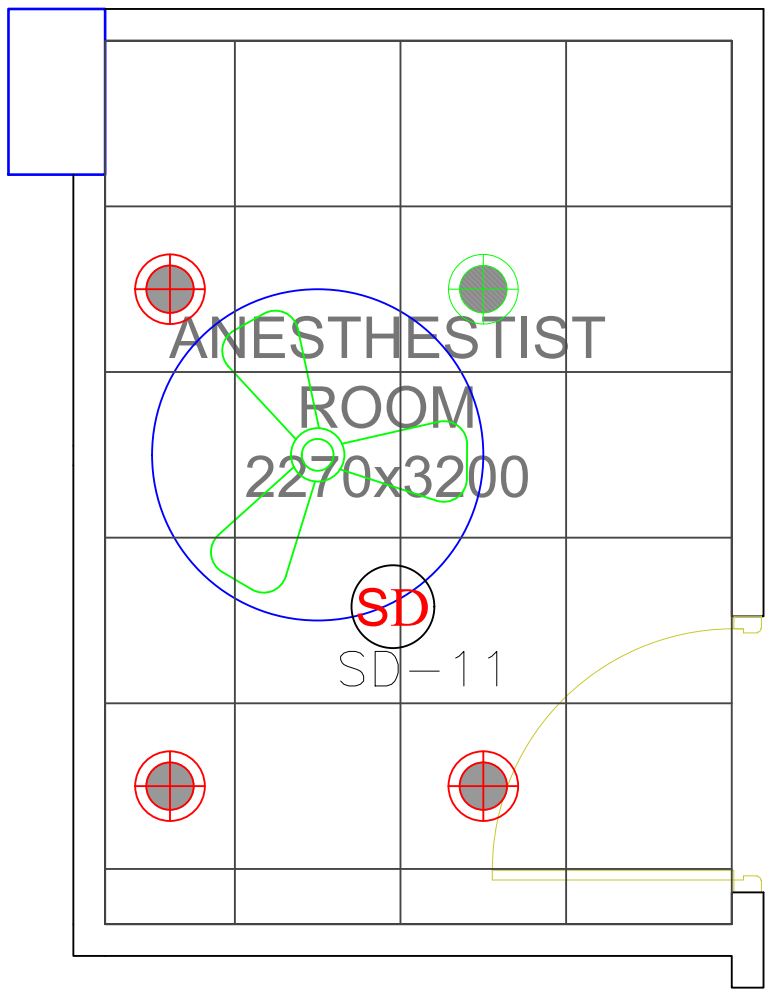


RCP

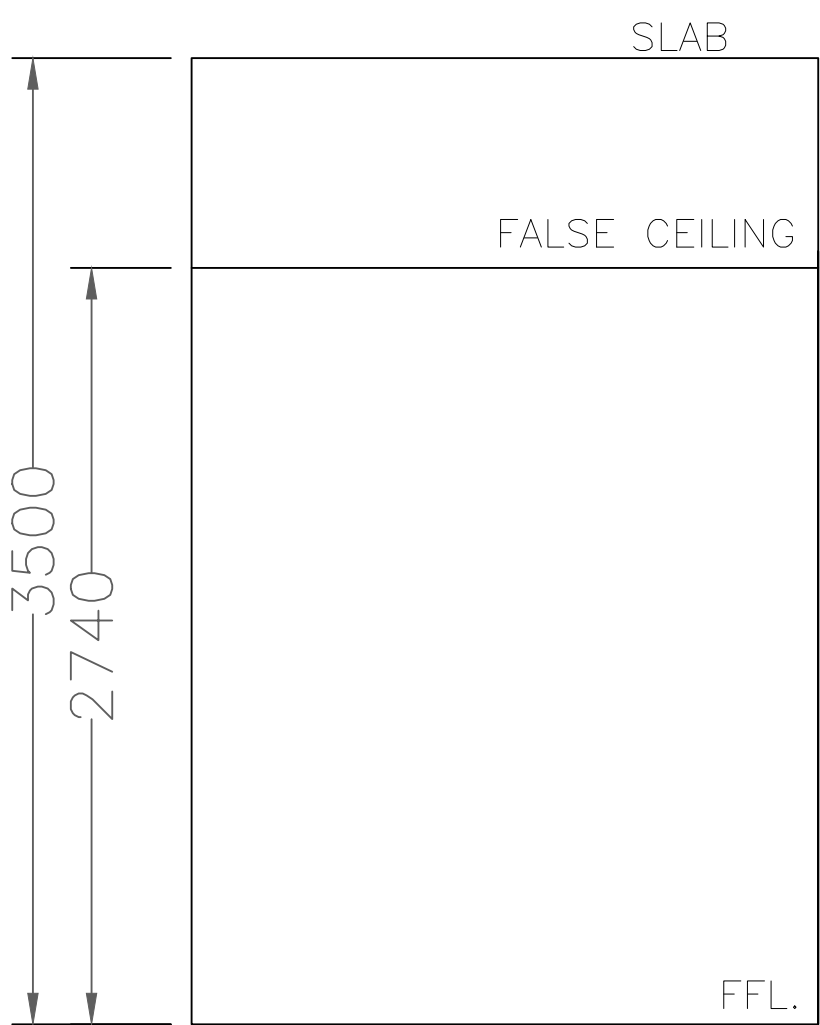


ELEVATION-1

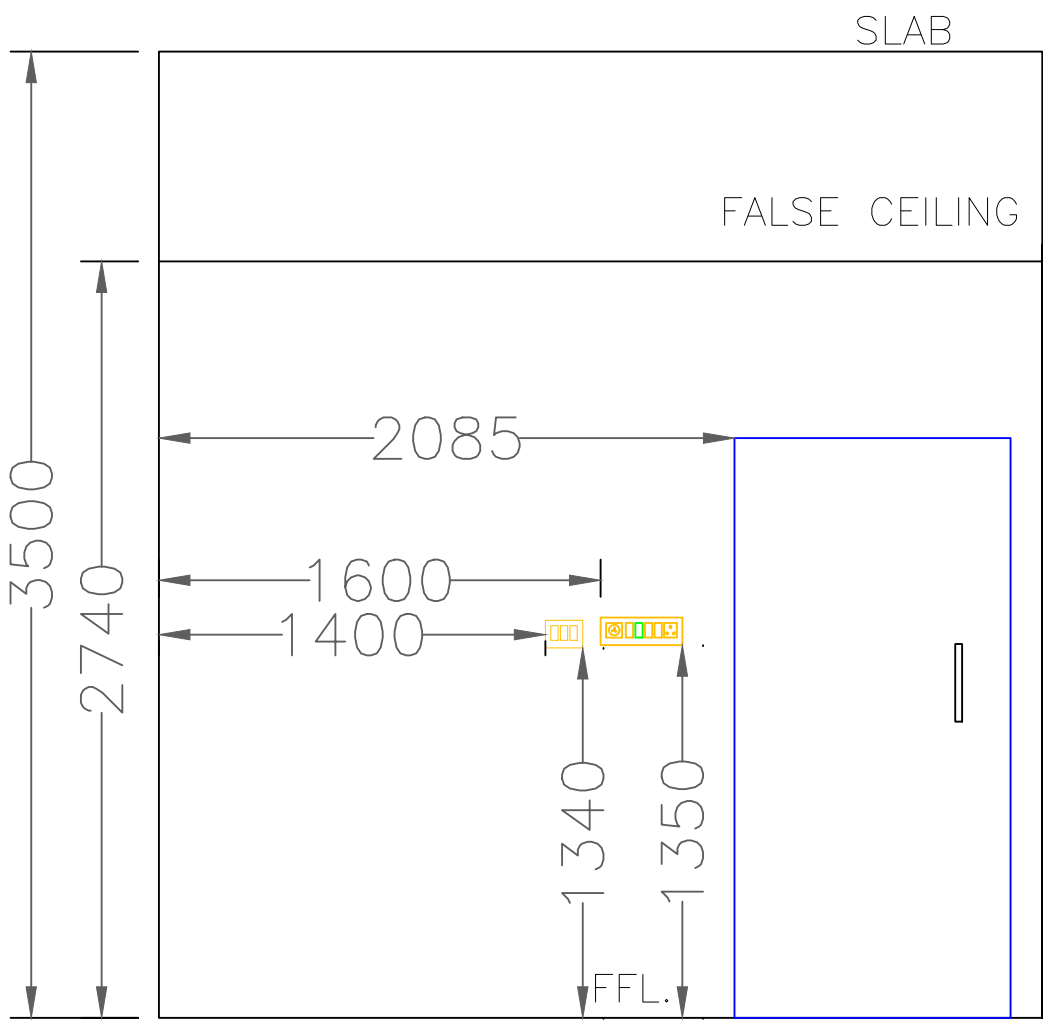


ELEVATION-2

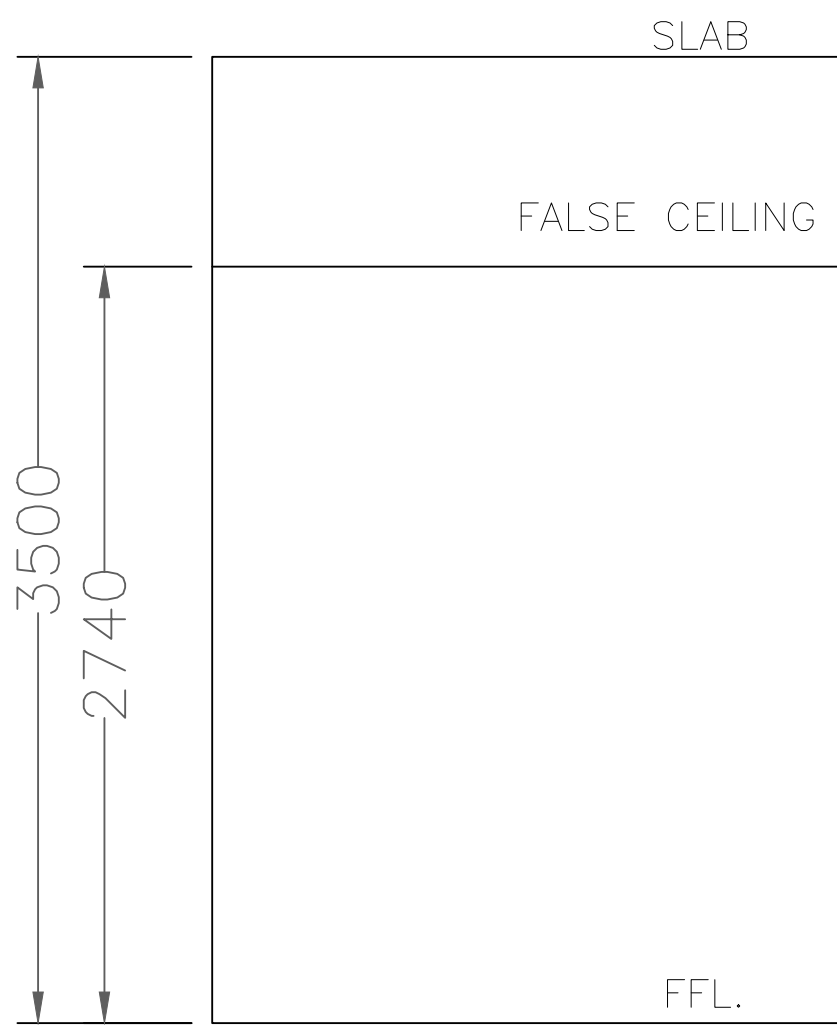

ELEVATION-3

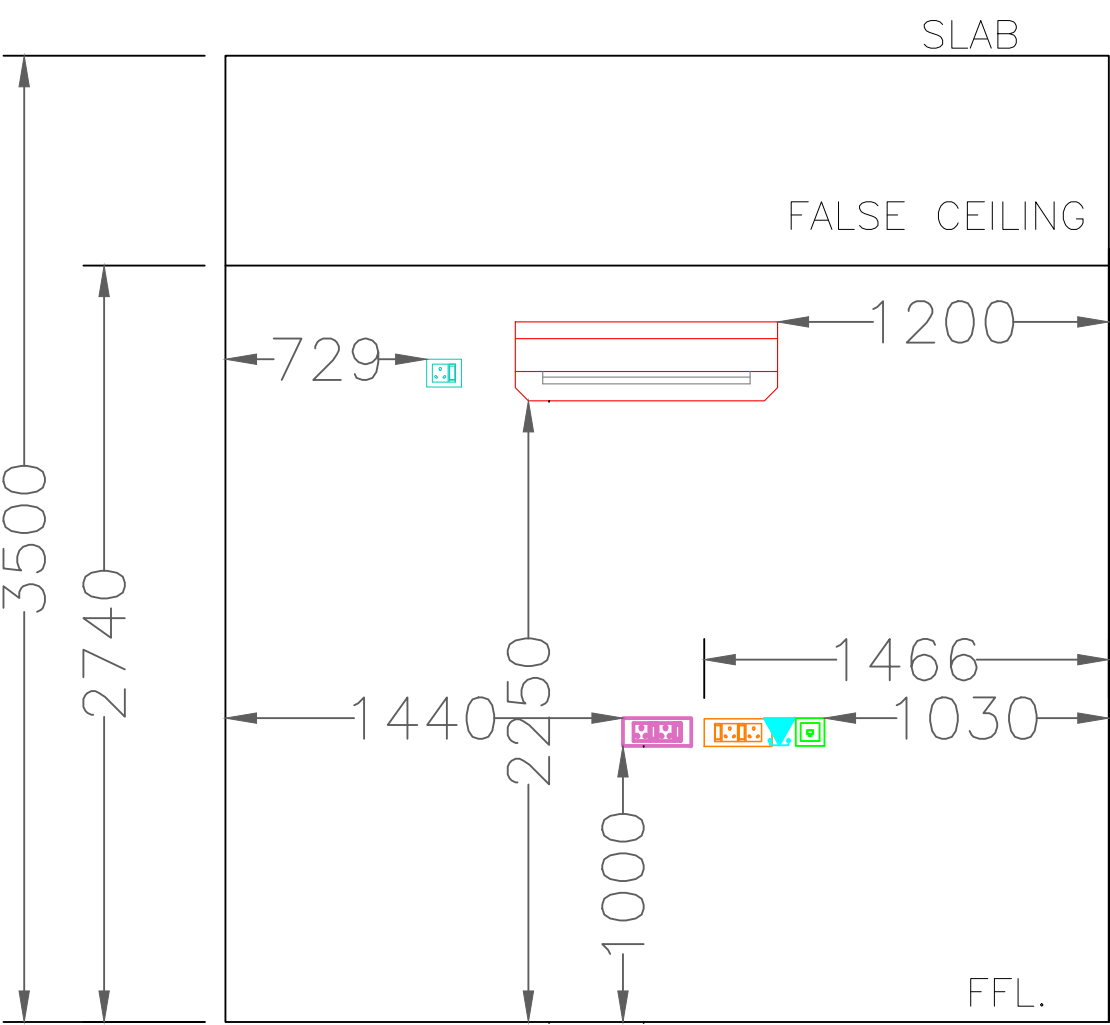

ELEVATION-4

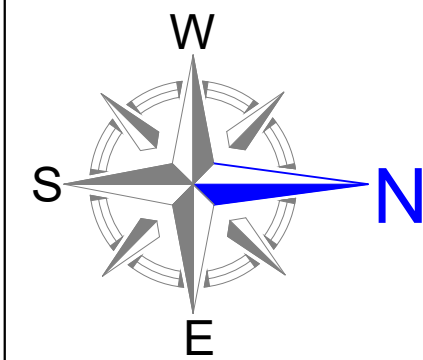

<div>TITLE :</div> <div>ANESTHETIST ROOM ELEVATION LAYOUT</div> <div>PURPOSE OF DRAWING :-</div> <div>PROPOSED <input type="checkbox"/> FOR APPROVAL <input type="checkbox"/></div> <div>WORKING <input type="checkbox"/> AS BUILT <input checked="" type="checkbox"/></div>	CLIENT :		PROJECT :	
	TELANGANA STATE MEDICAL SERVICES AND INFRASTRUCTURE DEVELOPMENT CORPORATION.		IFV CENTER ON THIRD FLOOR IN MODERN GOVERNMENT MATERNITY HOSPITAL, PETLABURJ, HYDERABAD ,TELANGANA.	
	DWG. No.:		CONTRACTOR :	
	AVC/TGMSIDC/IVFP/S/29		<div><div>ASTA</div><div>M/s Asta Vardhman Consortium H. NO. 8-2-334/27, Plot No. 27, Road No. 03, Banjara Hills, Hyderabad - 500034</div><div></div></div>	
	REV	R1	DATE	17-06-2024
SCALE	NTS	SHEET	29	