




ELEVATION-1

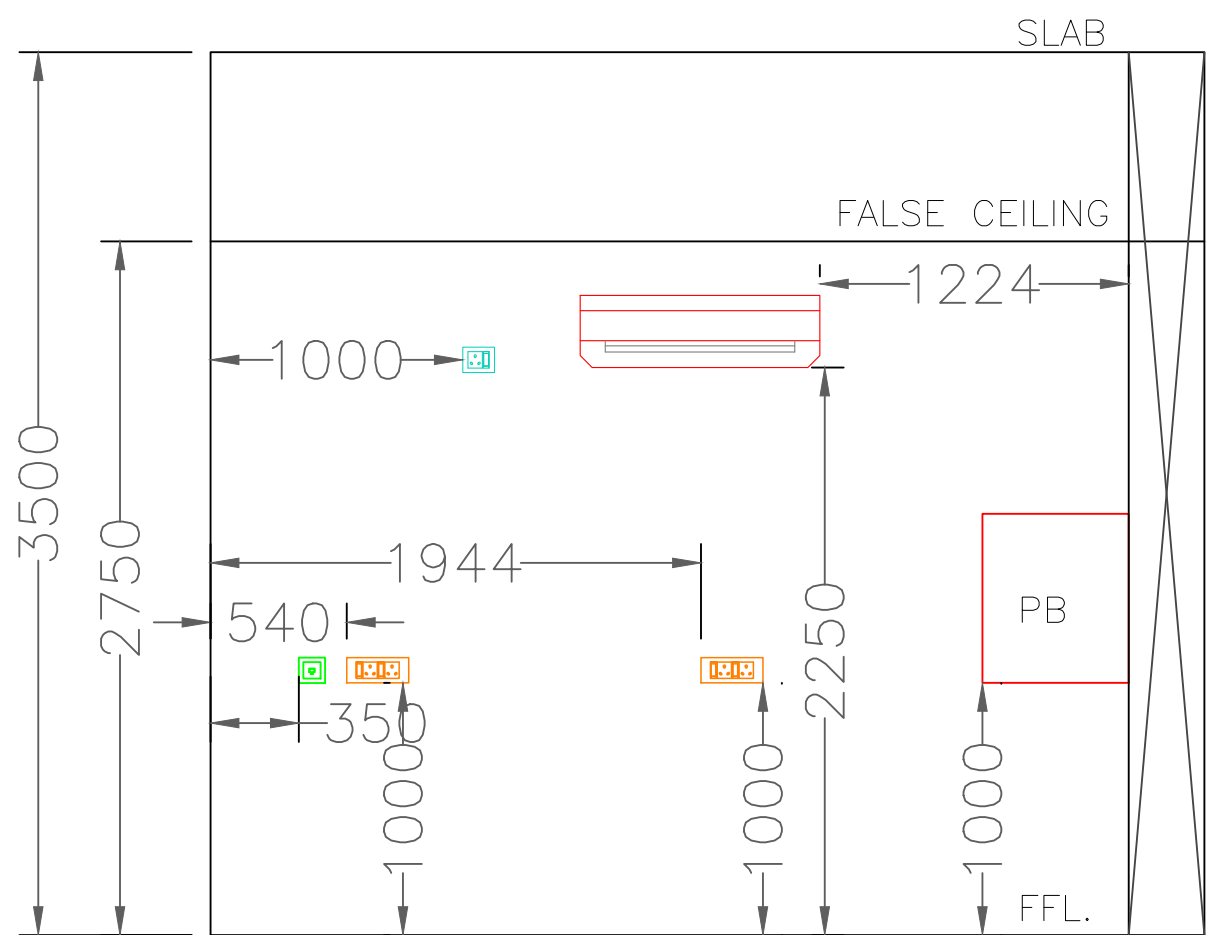


ELEVATION-2

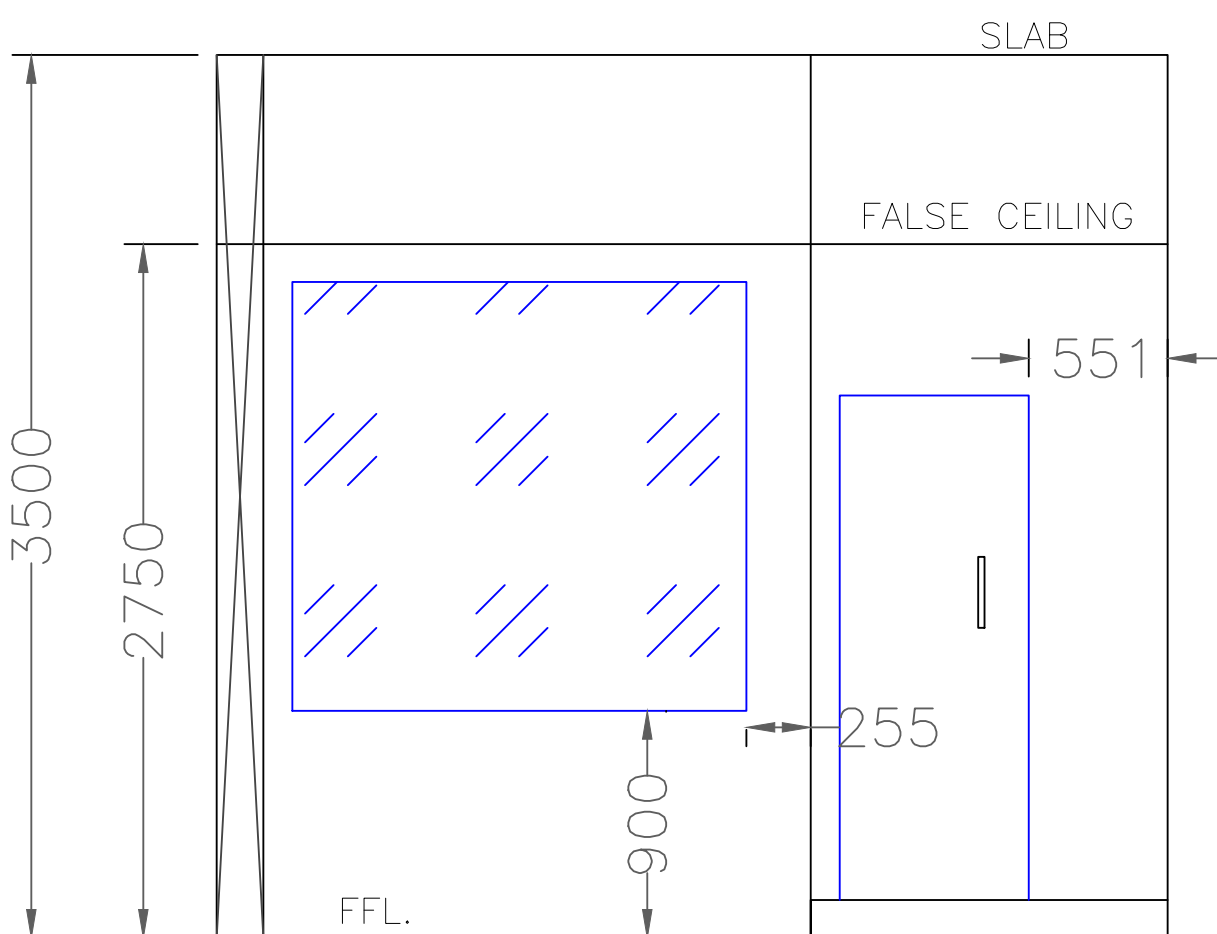

ELEVATION-3

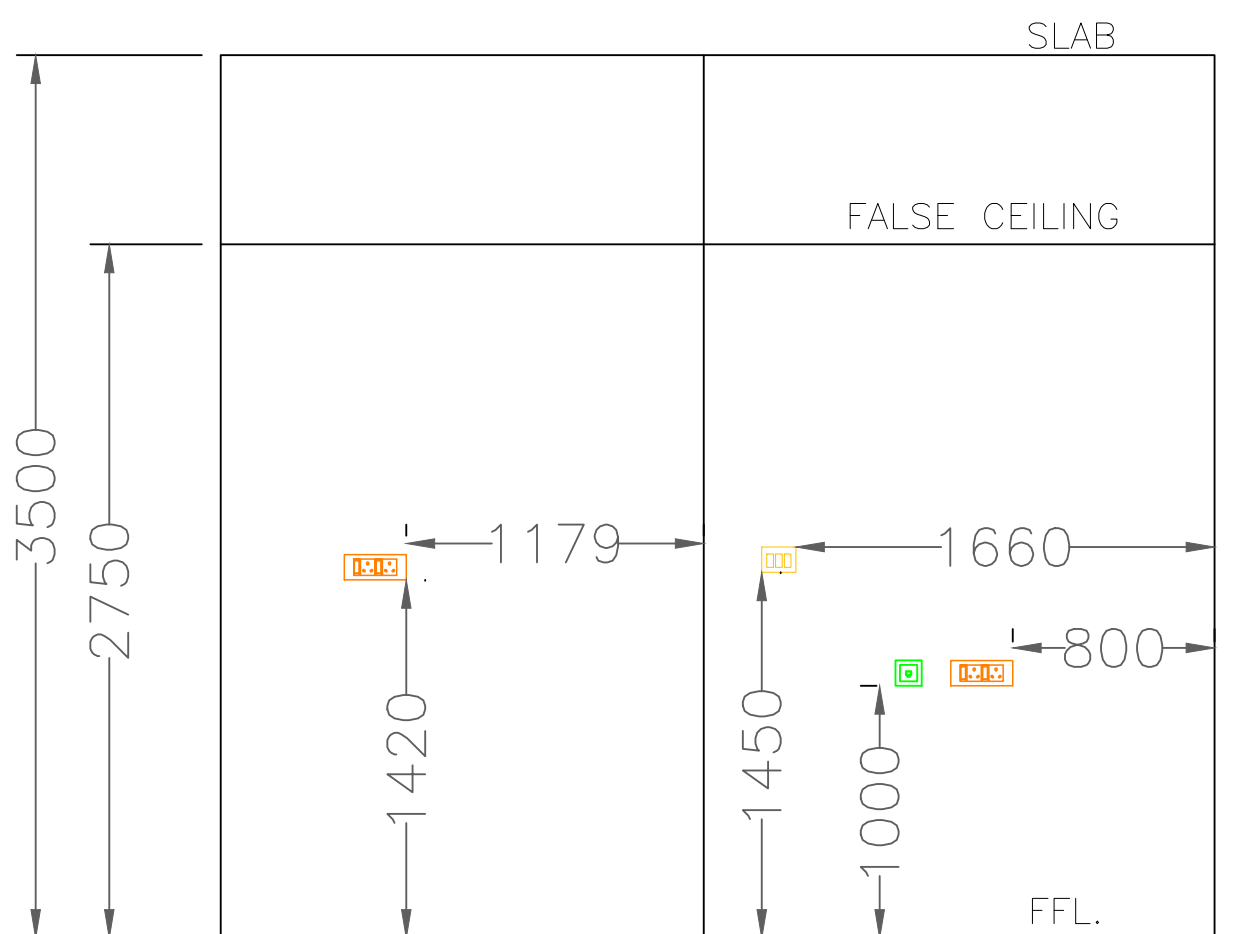


ELEVATION-4

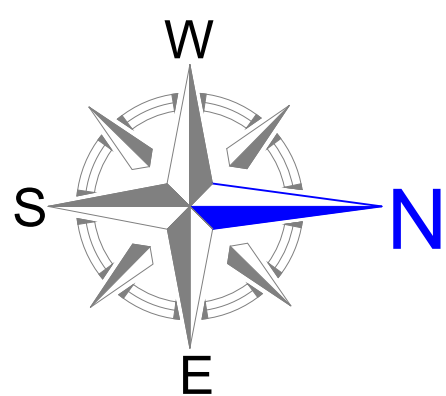

TITLE :	
SEMEN COLLECTION ROOM CORRIDOR ELEVATION LAYOUT	
PURPOSE OF DRAWING :-	
PROPOSED <input type="checkbox"/>	FOR APPROVAL <input type="checkbox"/>
WORKING <input type="checkbox"/>	AS BUILT <input checked="" type="checkbox"/>

CLIENT :			
TELANGANA STATE MEDICAL SERVICES AND INFRASTRUCTURE DEVELOPMENT CORPORATION.			
DWG. No.:			
AVC/TGMSIDC/IVFP/S/26			
REV	R1	DATE	17-06-2024
SCALE	NTS	SHEET	26

PROJECT :	
IFV CENTER ON SECOND FLOOR IN MOTHER & CHILD HOSPITAL BUILDING BESIDE GANDHI HOSPITAL , SECUNDERABAD ,TELANGANA.	
CONTRACTOR :	
	M/s Asta Vardhman Consortium H. NO. 8-2-334/27, Plot No. 27, Road No. 03, Banjara Hills, Hyderabad - 500034
