




PLAN

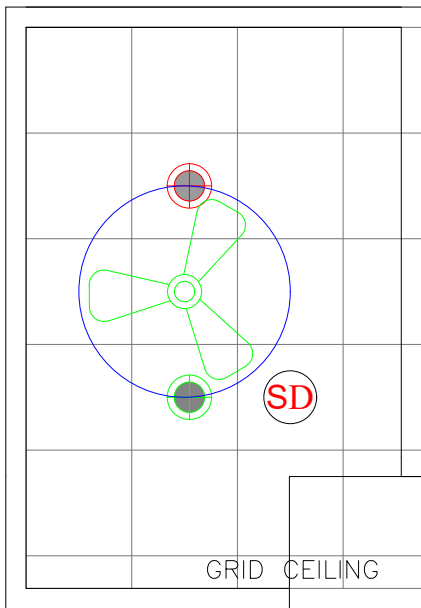


RCP PLAN

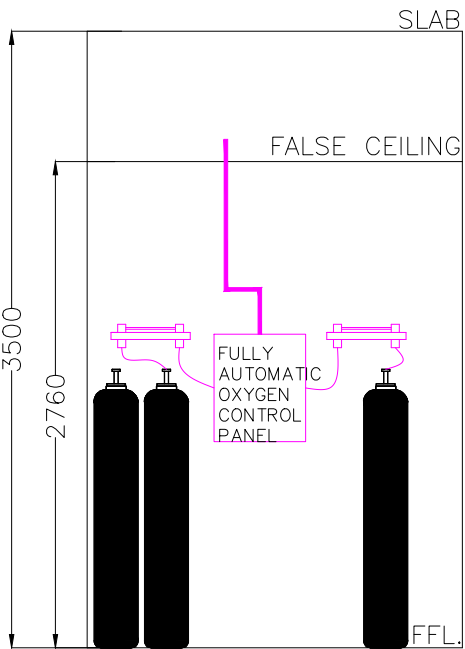


ELEVATION-1

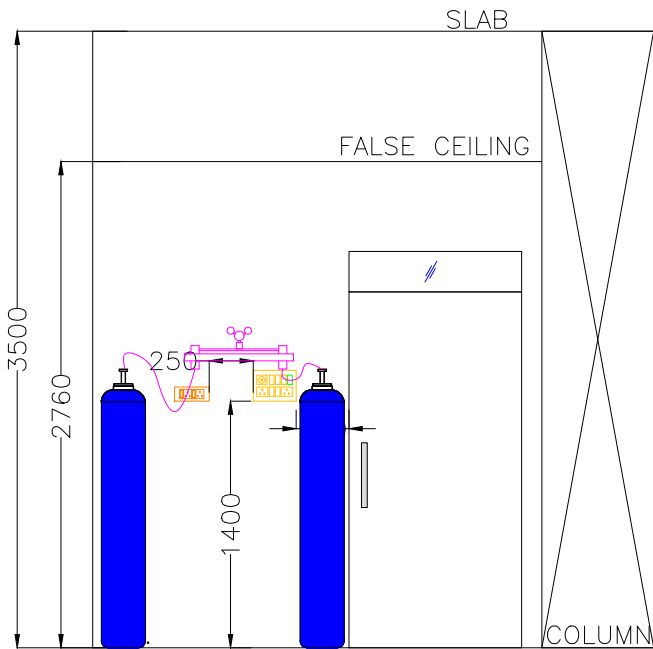



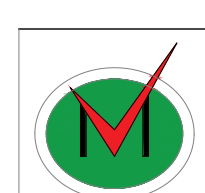
ELEVATION-2

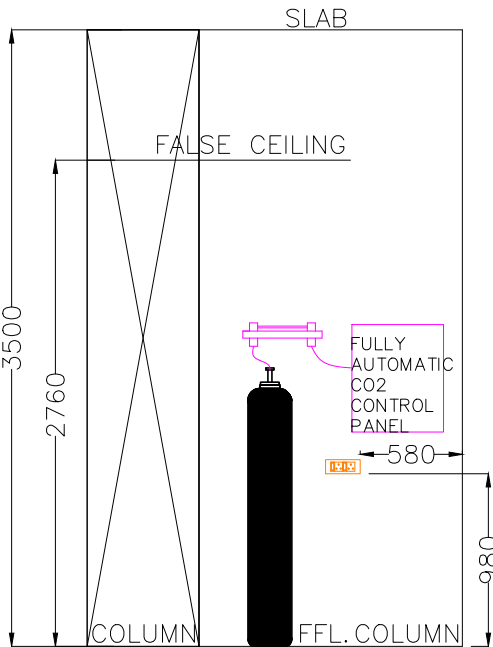

ELEVATION-3

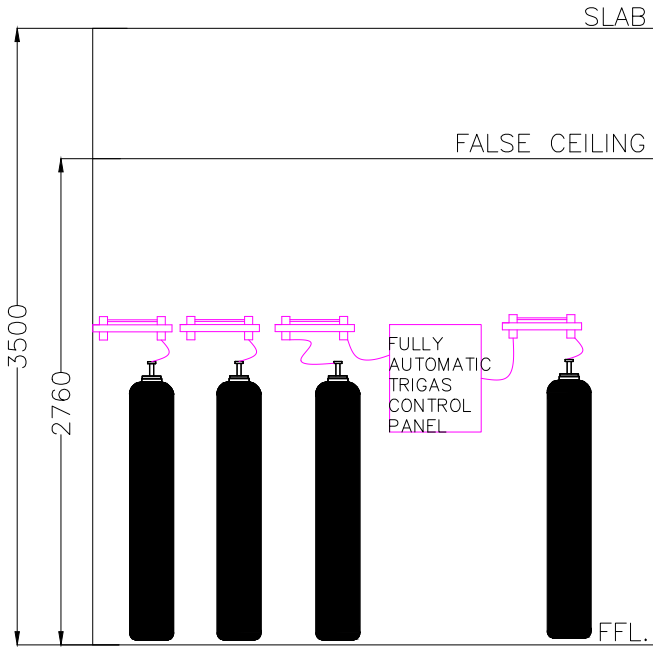

ELEVATION-4

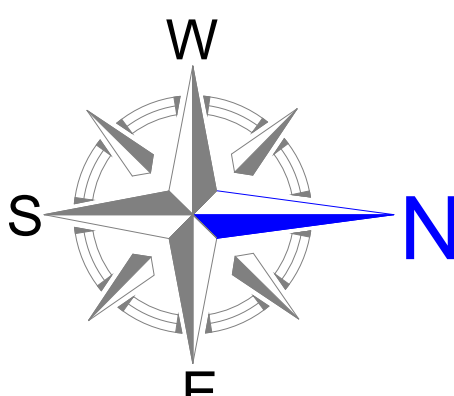	TITLE :	CLIENT :			PROJECT :		
	MANIFOLD ROOM ELEVATION LAYOUT	TELANGANA STATE MEDICAL SERVICES AND INFRASTRUCTURE DEVELOPMENT CORPORATION.			IFV CENTER ON SECOND FLOOR IN MOTHER & CHILD HOSPITAL BUILDING BESIDE GANDHI HOSPITAL , SECUNDERABAD ,TELANGANA.		
	PURPOSE OF DRAWING :- PROPOSED <input type="checkbox"/> FOR APPROVAL <input type="checkbox"/> WORKING <input type="checkbox"/> AS BUILT <input checked="" type="checkbox"/>	DWG. No.: AVC/TGMSIDC/IVFG/S/14			CONTRACTOR : <div>M/s Asta Vardhman Consortium H. NO. 8-2-334/27, Plot No. 27, Road No. 03, Banjara Hills, Hyderabad - 500034</div> <div></div>		
		REV	R4	DATE	04-06-2024		
	SCALE	NTS	SHEET	26			