




PLAN

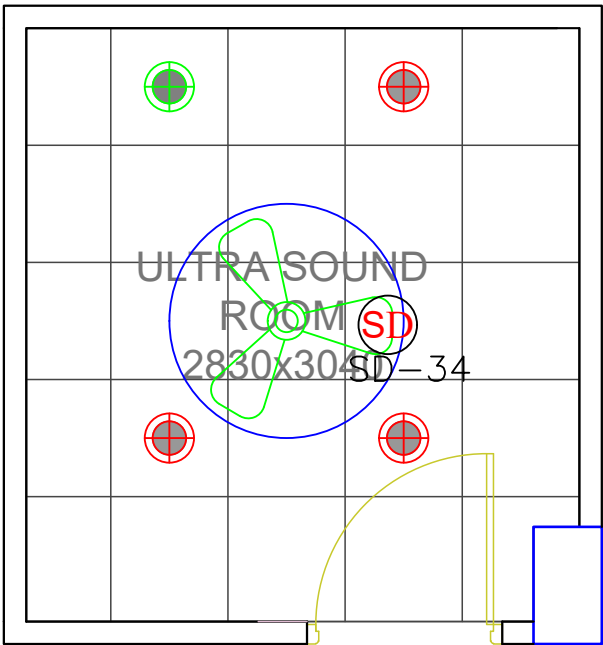


RCP

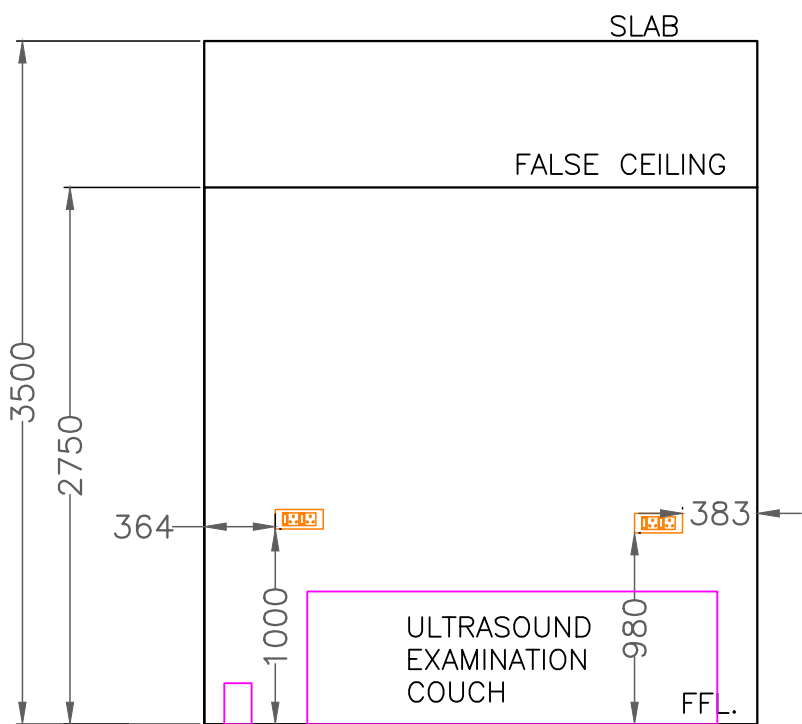


ELEVATION-1

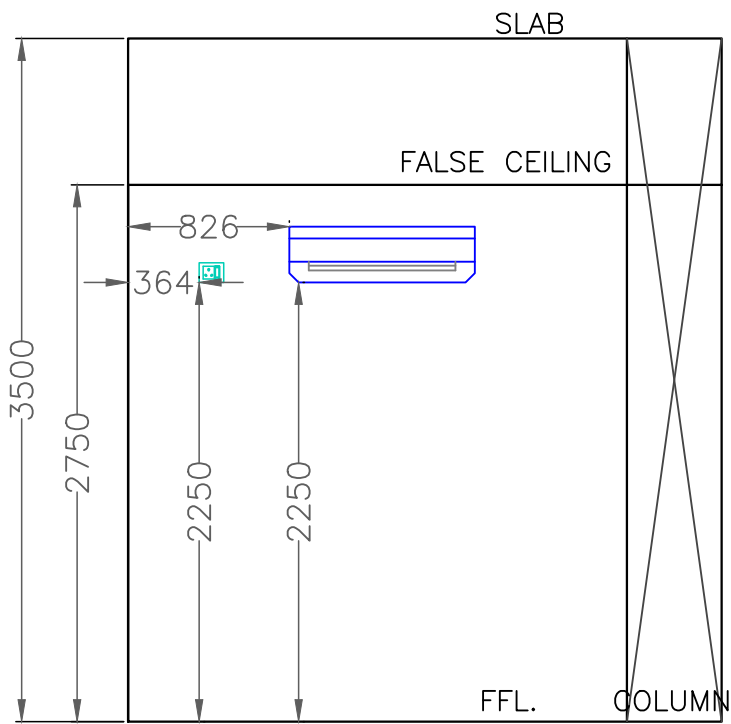


ELEVATION-2

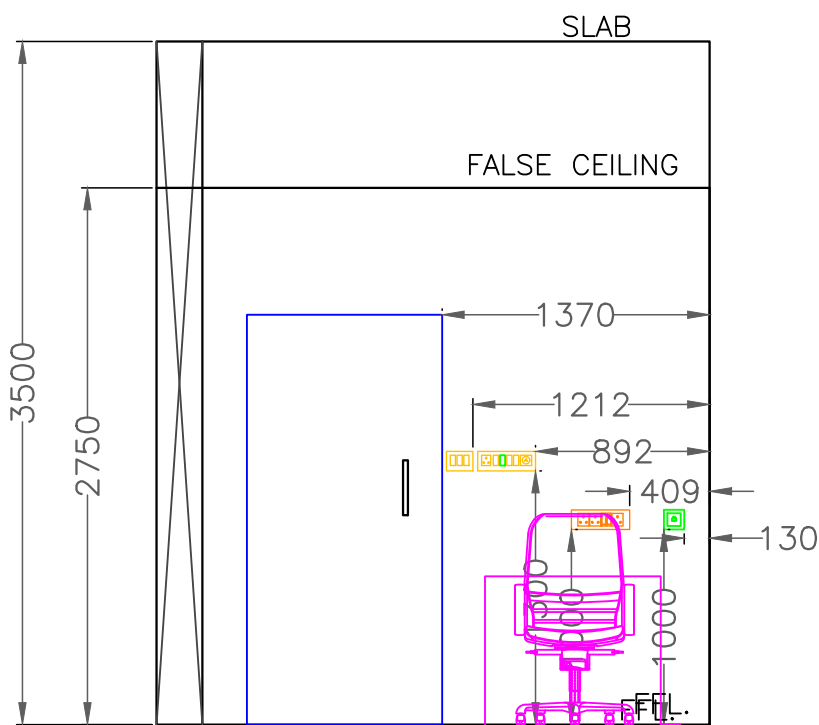

ELEVATION-3

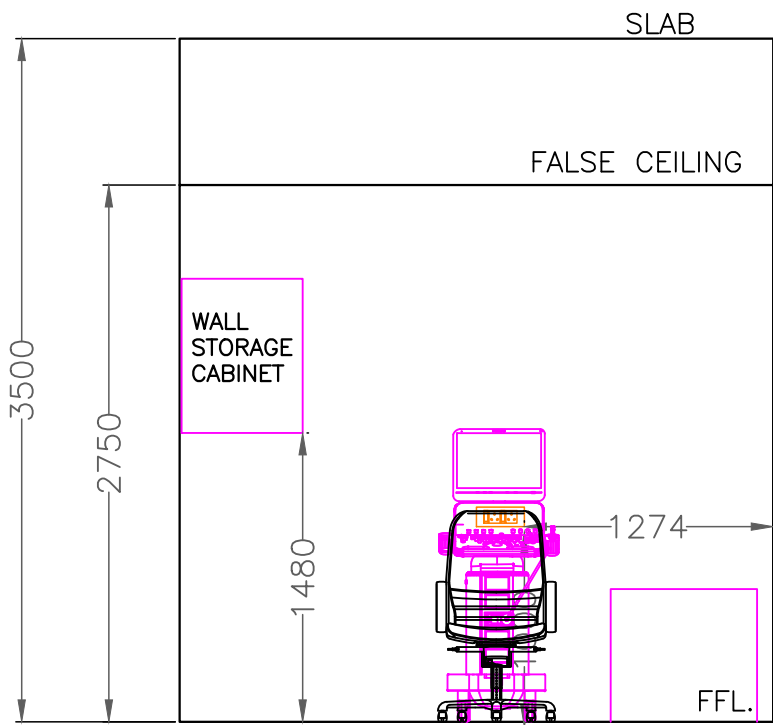

ELEVATION-4

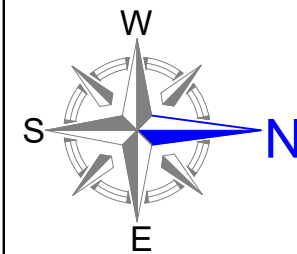

TITLE :	CLIENT :	PROJECT :							
ULTRASOUND ROOM ELEVATION LAYOUT	TELANGANA STATE MEDICAL SERVICES AND INFRASTRUCTURE DEVELOPMENT CORPORATION.	IFV CENTER ON THIRD FLOOR IN MODERN GOVERNMENT MATERNITY HOSPITAL, PETLABURJ, HYDERABAD ,TELANGANA.							
PURPOSE OF DRAWING :-	DWG. No.:	CONTRACTOR :							
PROPOSED <input type="checkbox"/> FOR APPROVAL <input type="checkbox"/>	AVC/TGMSIDC/IVFP/S/07	<div data-bbox="1480 2834 1575 2938"> </div> <div data-bbox="1585 2834 1785 2938"> M/s Asta Vardhman Consortium H. NO. 8-2-334/27, Plot No. 27, Road No. 03, Banjara Hills, Hyderabad - 500034 </div> <div data-bbox="1795 2834 1911 2938"> </div>							
WORKING <input type="checkbox"/> AS BUILT <input checked="" type="checkbox"/>	<table border="1"> <tr> <td>REV</td><td>R2</td><td>DATE</td><td>20-06-2024</td></tr> <tr> <td>SCALE</td><td>NTS</td><td>SHEET</td><td>7</td></tr> </table>			REV	R2	DATE	20-06-2024	SCALE	NTS
REV	R2	DATE	20-06-2024						
SCALE	NTS	SHEET	7						