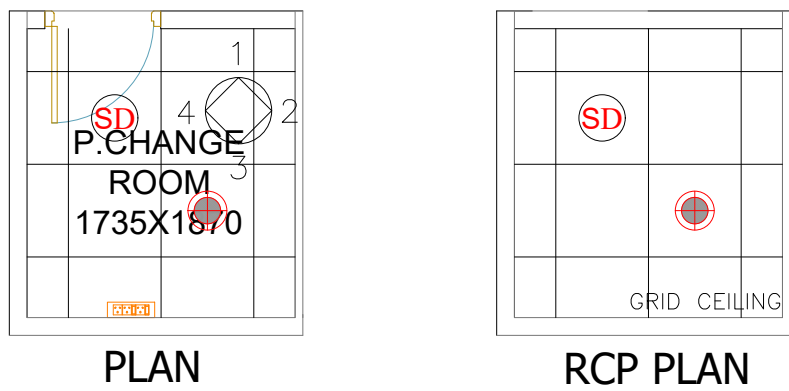
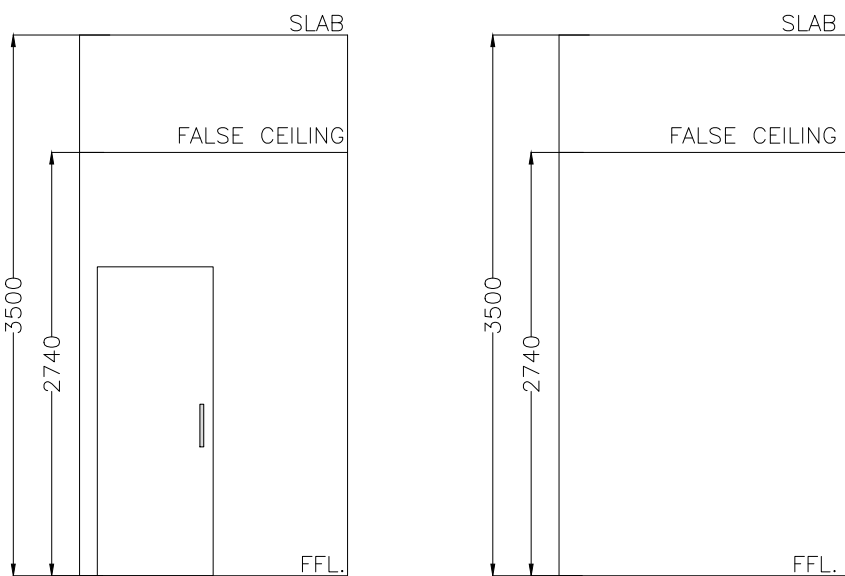
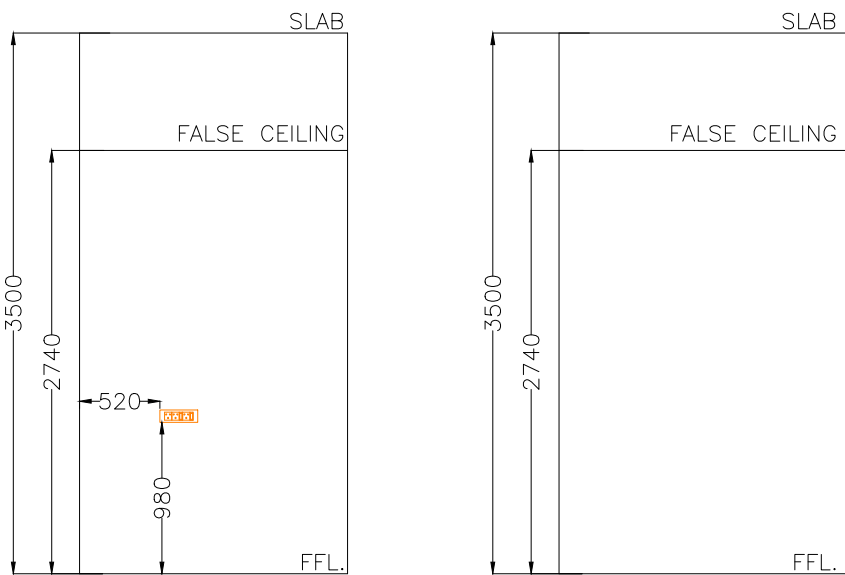
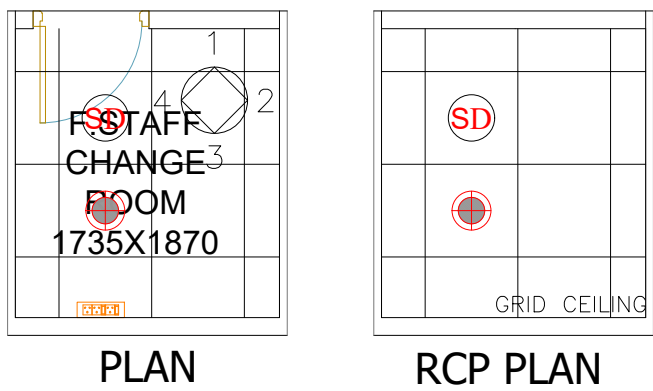
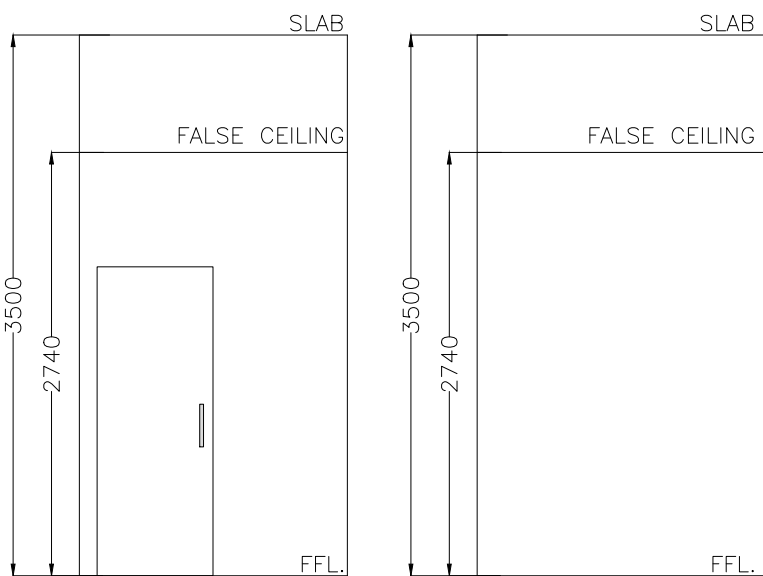
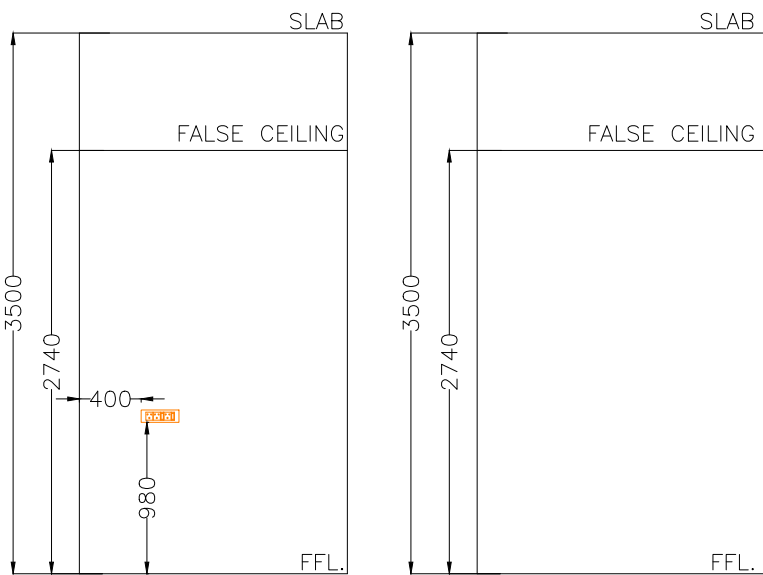
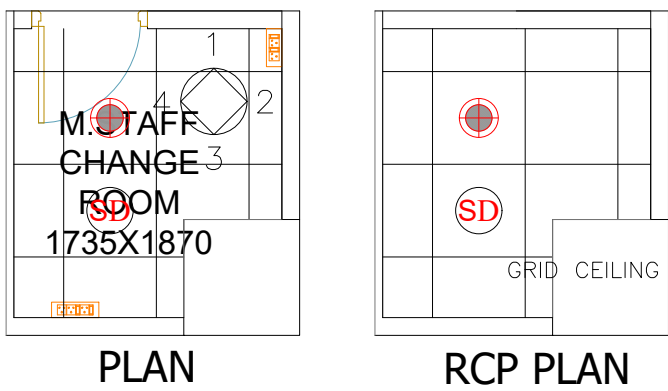
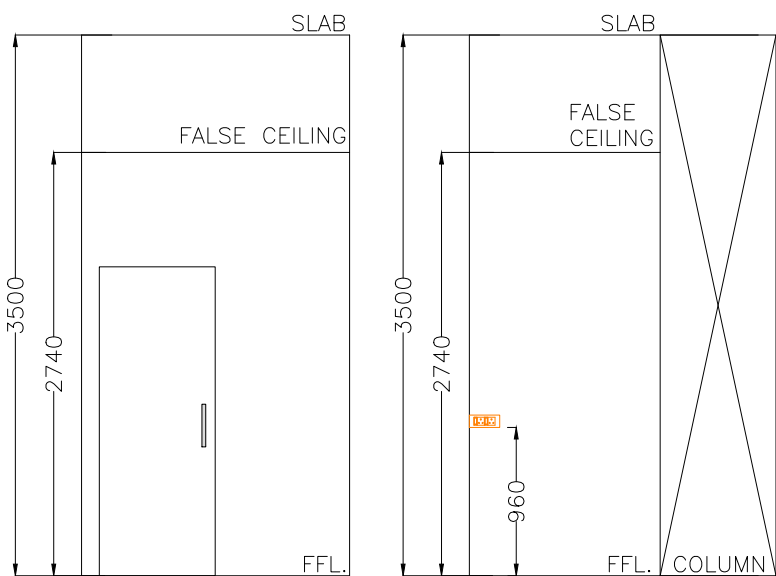
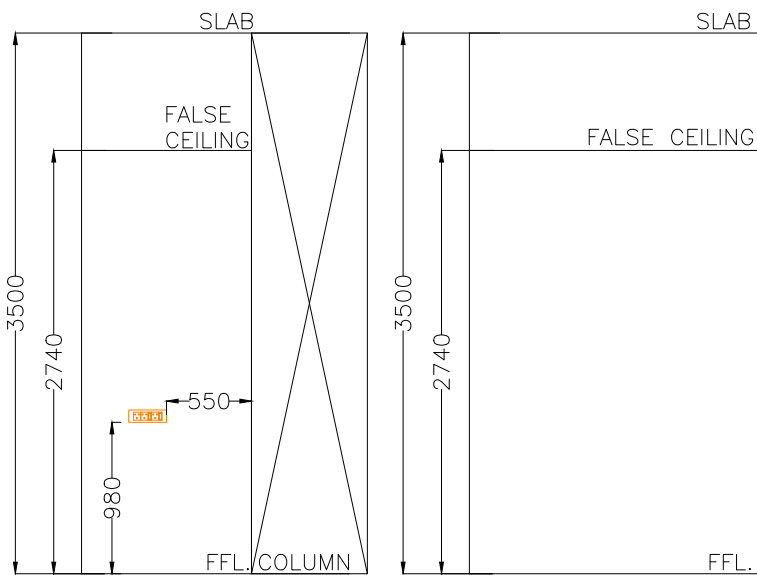
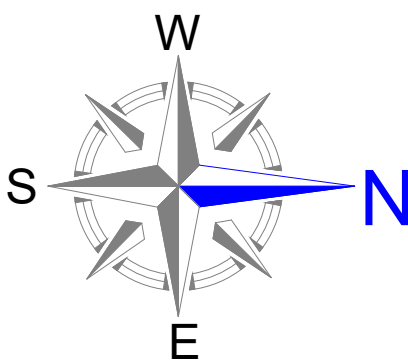

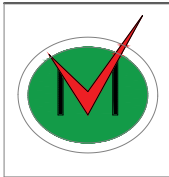


<div><div><div>P STAFF CHANGE ROOM</div><div><div>PLANRCP PLAN</div></div><div><div>ELEVATION-1ELEVATION-2</div><div></div></div><div><div>ELEVATION-3ELEVATION-4</div><div></div></div></div></div>				<div><div><div>F STAFF CHANGE ROOM</div><div><div>PLANRCP PLAN</div></div><div><div>ELEVATION-1ELEVATION-2</div><div></div></div><div><div>ELEVATION-1ELEVATION-2</div><div></div></div></div></div>				<div><div><div>M STAFF CHANGE ROOM</div><div><div>PLANRCP PLAN</div></div><div><div>ELEVATION-1ELEVATION-2</div><div></div></div><div><div>ELEVATION-1ELEVATION-2</div><div></div></div></div></div>			
	TITLE :		CLIENT :		PROJECT :						
	CHANGE ROOMS ELEVATION LAYOUT		TELANGANA STATE MEDICAL SERVICES AND INFRASTRUCTURE DEVELOPMENT CORPORATION.		IFV CENTER ON SECOND FLOOR IN MOTHER & CHILD HOSPITAL BUILDING BESIDE GANDHI HOSPITAL , SECUNDERABAD ,TELANGANA.						
	PURPOSE OF DRAWING :-		DWG. No.:		CONTRACTOR :						
	PROPOSED <input type="checkbox"/> FOR APPROVAL <input type="checkbox"/> WORKING <input type="checkbox"/> AS BUILT <input checked="" type="checkbox"/>		AVC/TGMSIDC/IVFG/S/10		<div><div></div><div>M/s Asta Vardhman Consortium H. NO. 8-2-334/27, Plot No. 27, Road No. 03, Banjara Hills, Hyderabad - 500034</div><div></div></div>						
REV		R4	DATE	04-06-2024							
SCALE		NTS	SHEET	22							