




PLAN

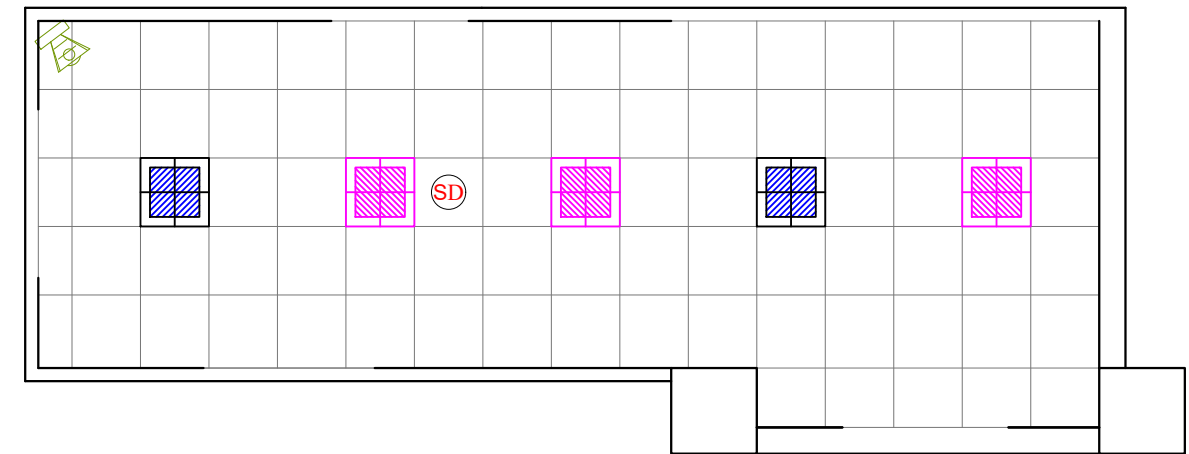


RCP PLAN

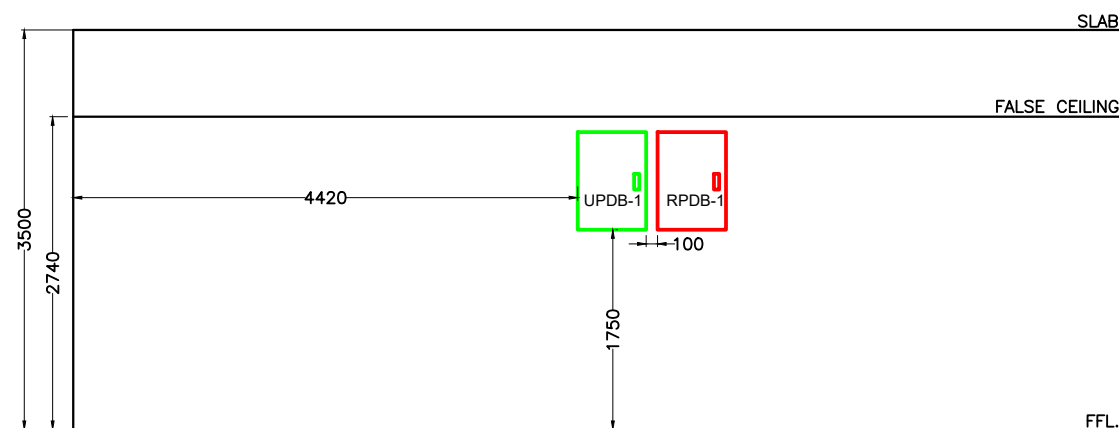


ELEVATION-1

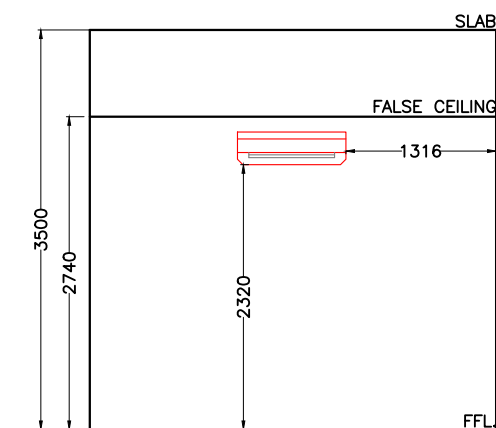


ELEVATION-2

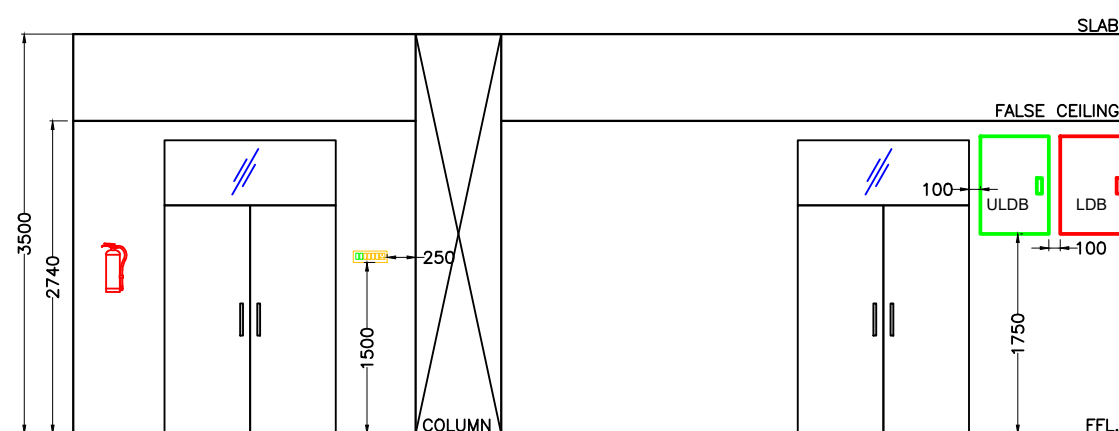

ELEVATION-3

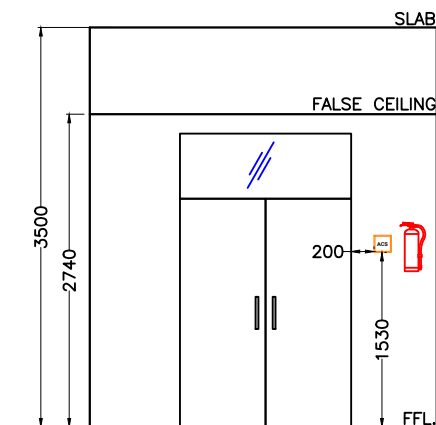

ELEVATION-4

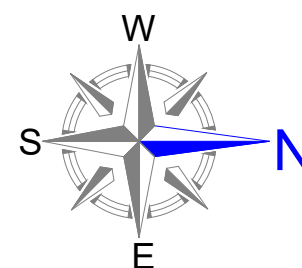

TITLE :

NON STERILE AREA  
ELEVATION LAYOUT

PURPOSE OF DRAWING :-

PROPOSED ☐ FOR APPROVAL ☐  
WORKING ☐ AS BUILT ☒

CLIENT :

TELANGANA STATE MEDICAL  
SERVICES AND INFRASTRUCTURE  
DEVELOPMENT CORPORATION.

DWG. No.:

AVC/TGMSIDC/IVFG/S/20


REV R5 DATE 20-06-2024

SCALE NTS SHEET 32

PROJECT :

IFV CENTER ON SECOND FLOOR IN  
MOTHER & CHILD HOSPITAL BUILDING  
BESIDE GANDHI HOSPITAL ,  
SECUNDERABAD ,TELANGANA.

CONTRACTOR :

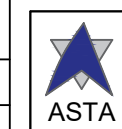

M/s Asta Vardhman Consortium  
H. NO. 8-2-334/27, Plot No. 27,  
Road No. 03, Banjara Hills,  
Hyderabad - 500034

