




PLAN

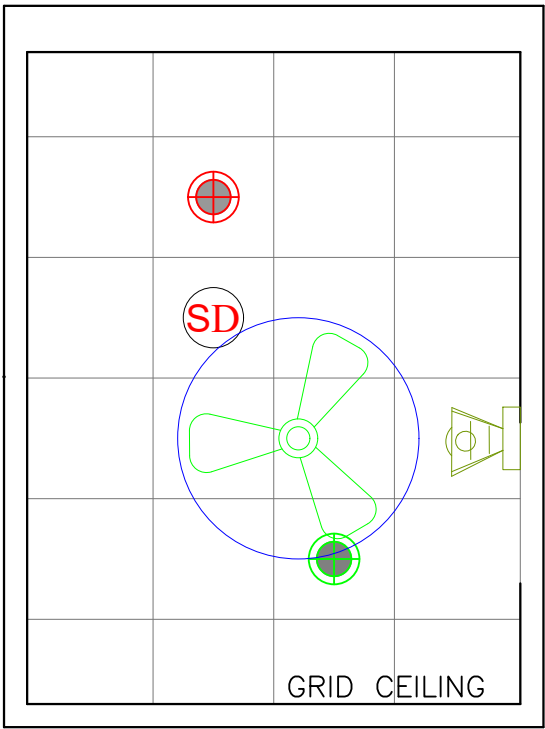


RCP PLAN

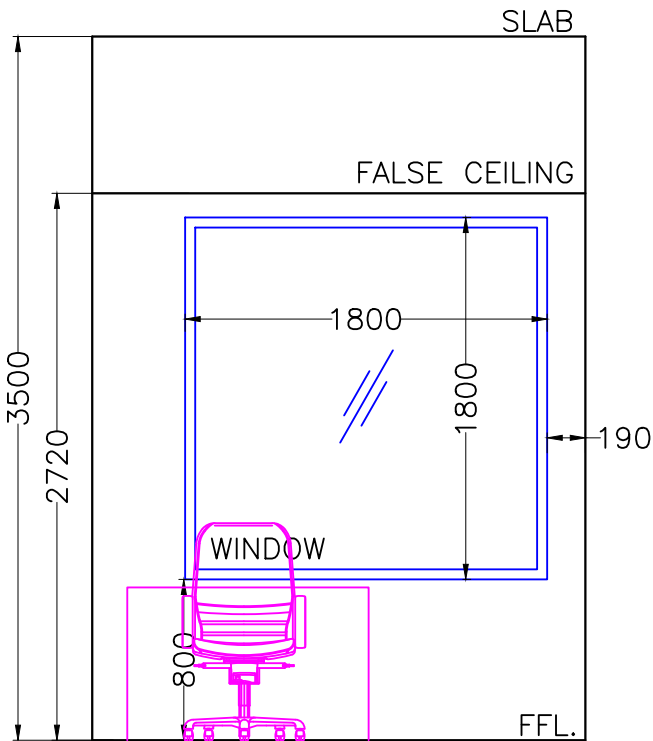


ELEVATION-1

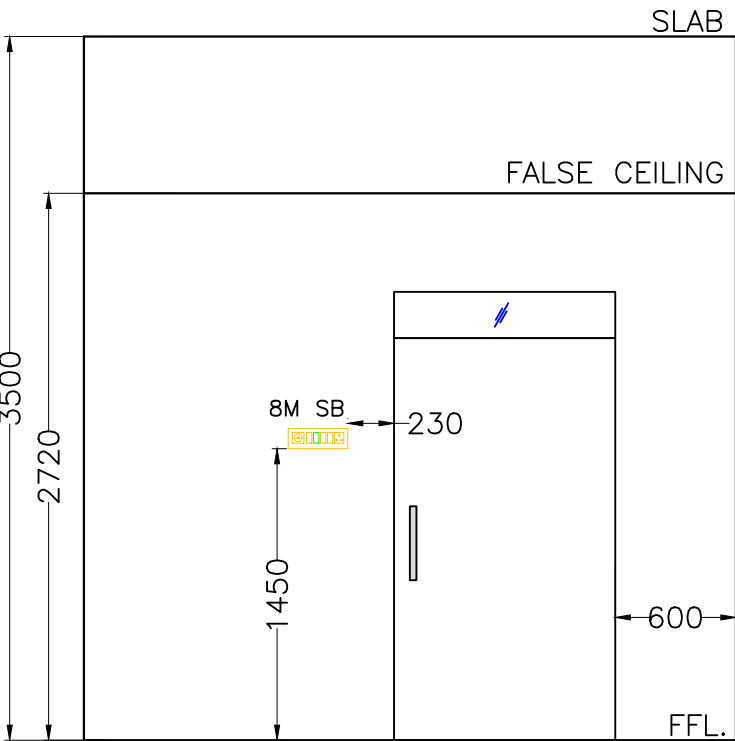


ELEVATION-2

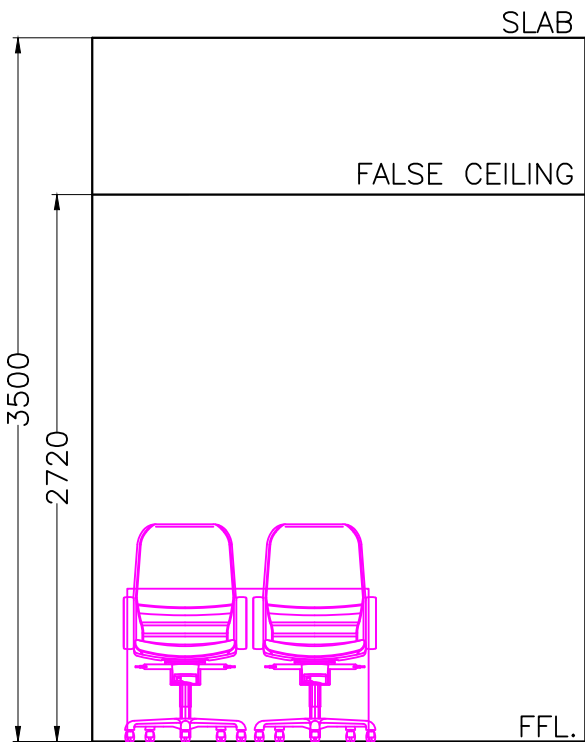

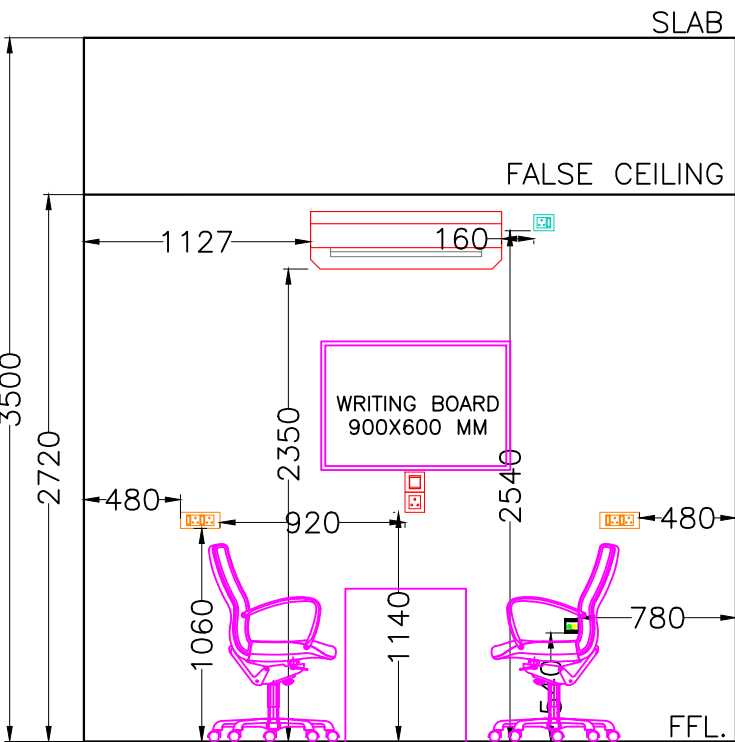

ELEVATION-3

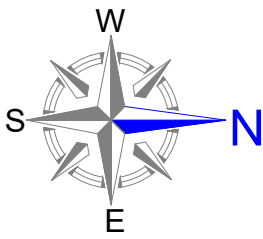

ELEVATION-4



TITLE :		CLIENT :		PROJECT :	
COUNSELLING ROOM-2 ELEVATION LAYOUT		TELANGANA STATE MEDICAL SERVICES AND INFRASTRUCTURE DEVELOPMENT CORPORATION.		IFV CENTER ON SECOND FLOOR IN MOTHER & CHILD HOSPITAL BUILDING BESIDE GANDHI HOSPITAL , SECUNDERABAD ,TELANGANA.	
PURPOSE OF DRAWING :-  PROPOSED <input type="checkbox"/> FOR APPROVAL <input type="checkbox"/>  WORKING <input type="checkbox"/> AS BUILT <input checked="" type="checkbox"/>		DWG. No.: AVC/TGMSIDC/IVFG/S/07		CONTRACTOR :	
		REV	R5	DATE	20-06-2024
		SCALE	NTS	SHEET	19
				 M/s Asta Vardhman Consortium H. NO. 8-2-334/27, Plot No. 27, Road No. 03, Banjara Hills, Hyderabad - 500034	