




PLAN

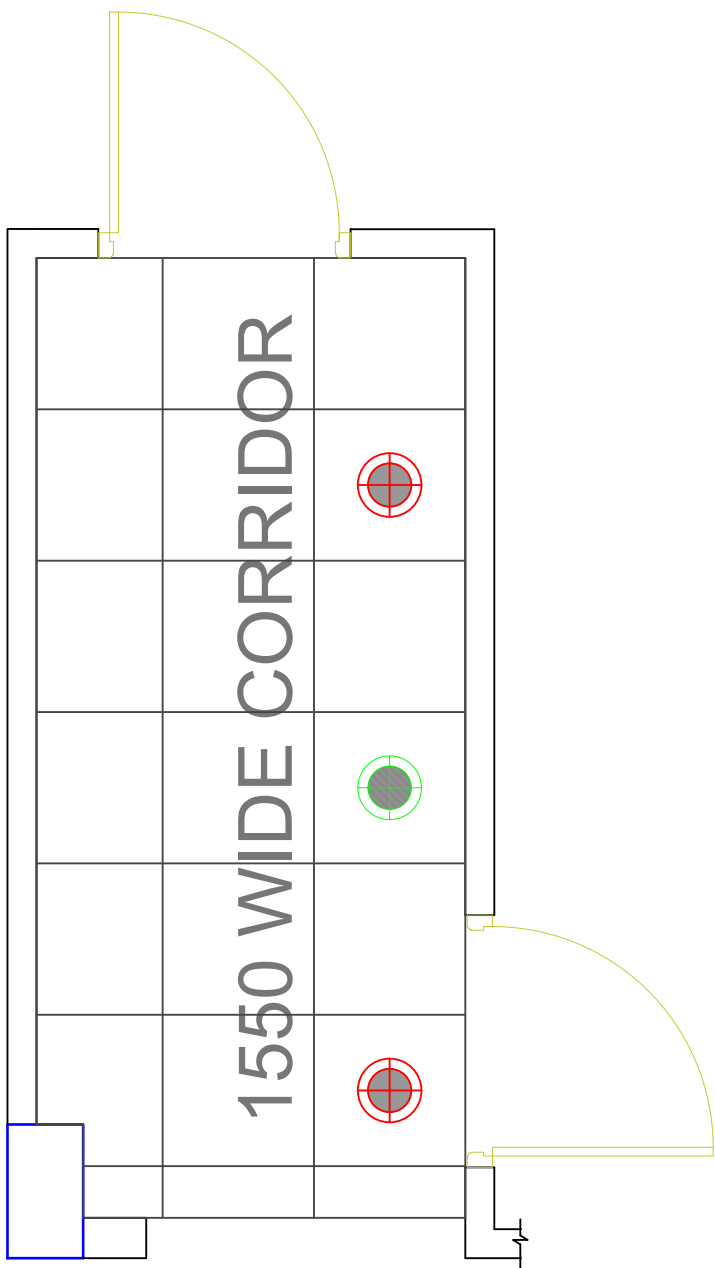


RCP

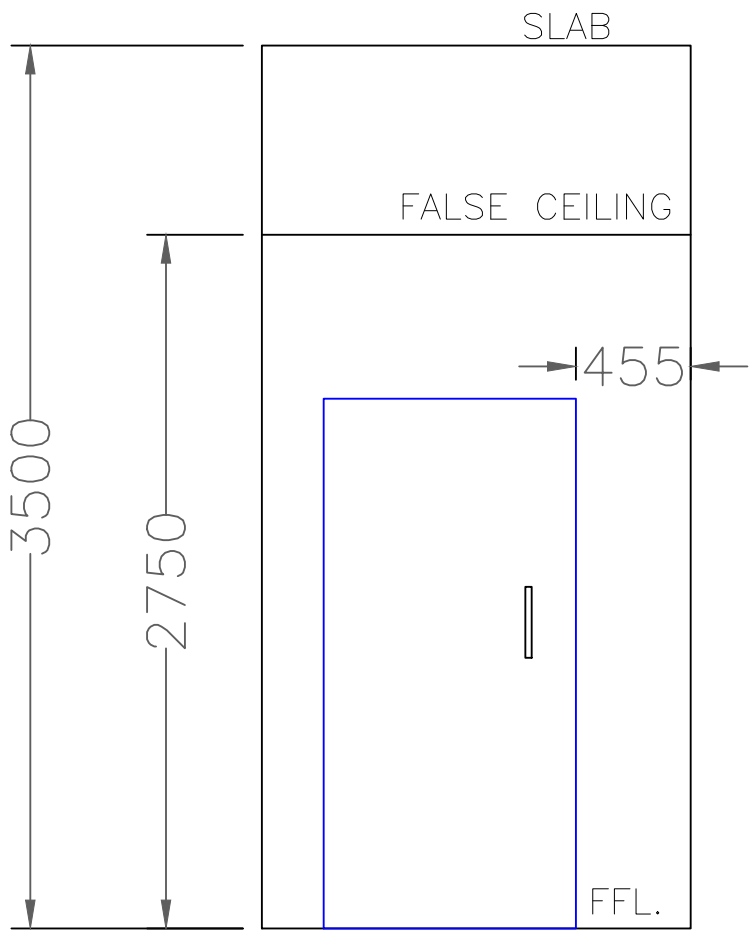


ELEVATION-1

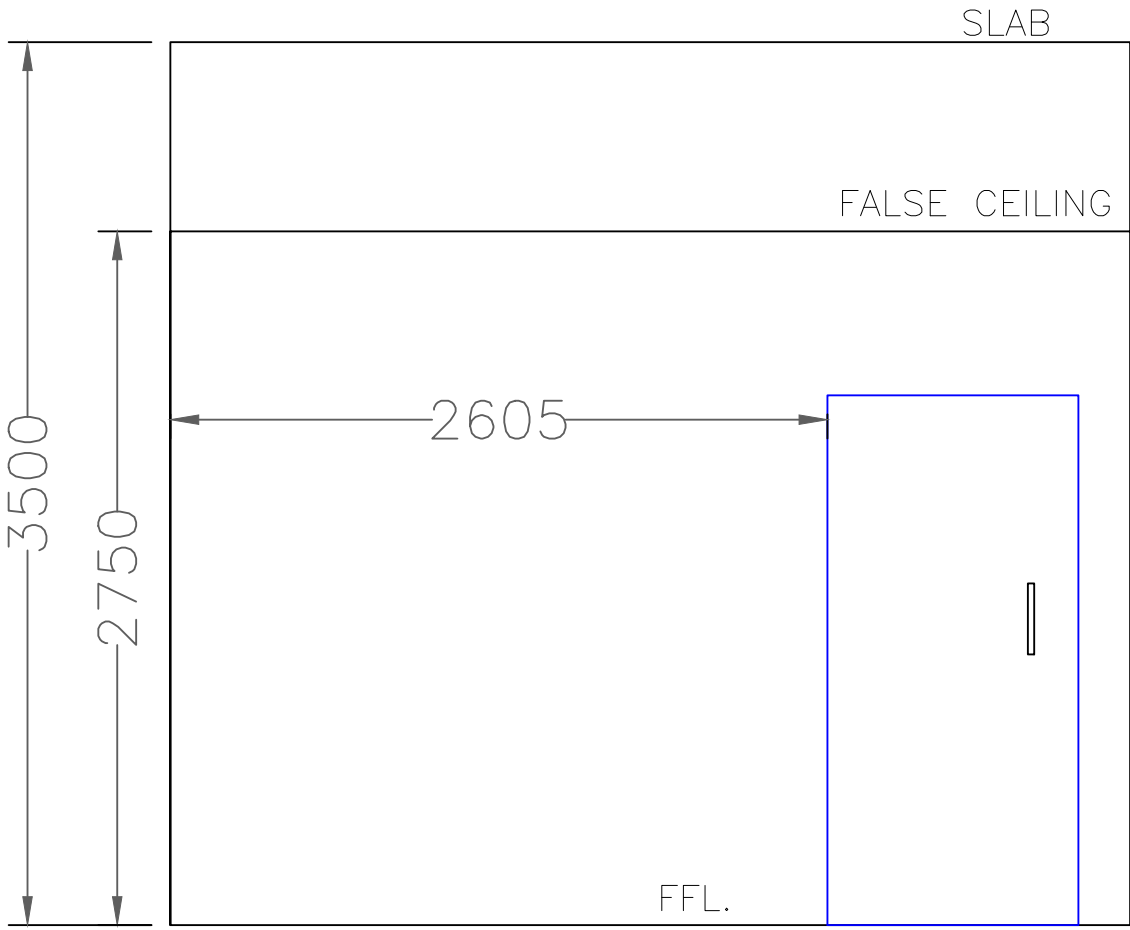

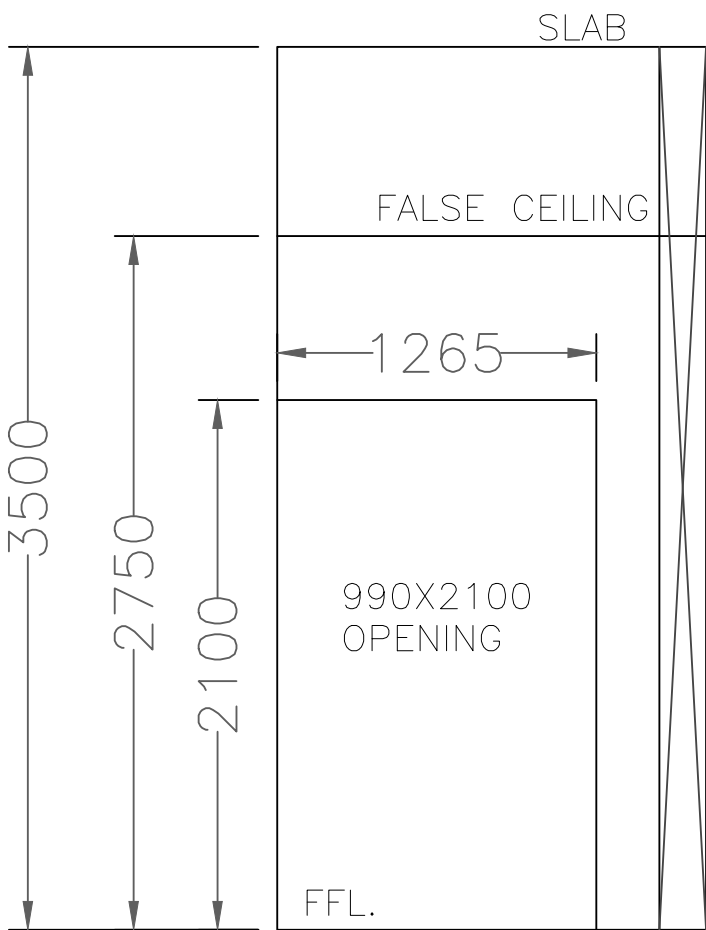


ELEVATION-2

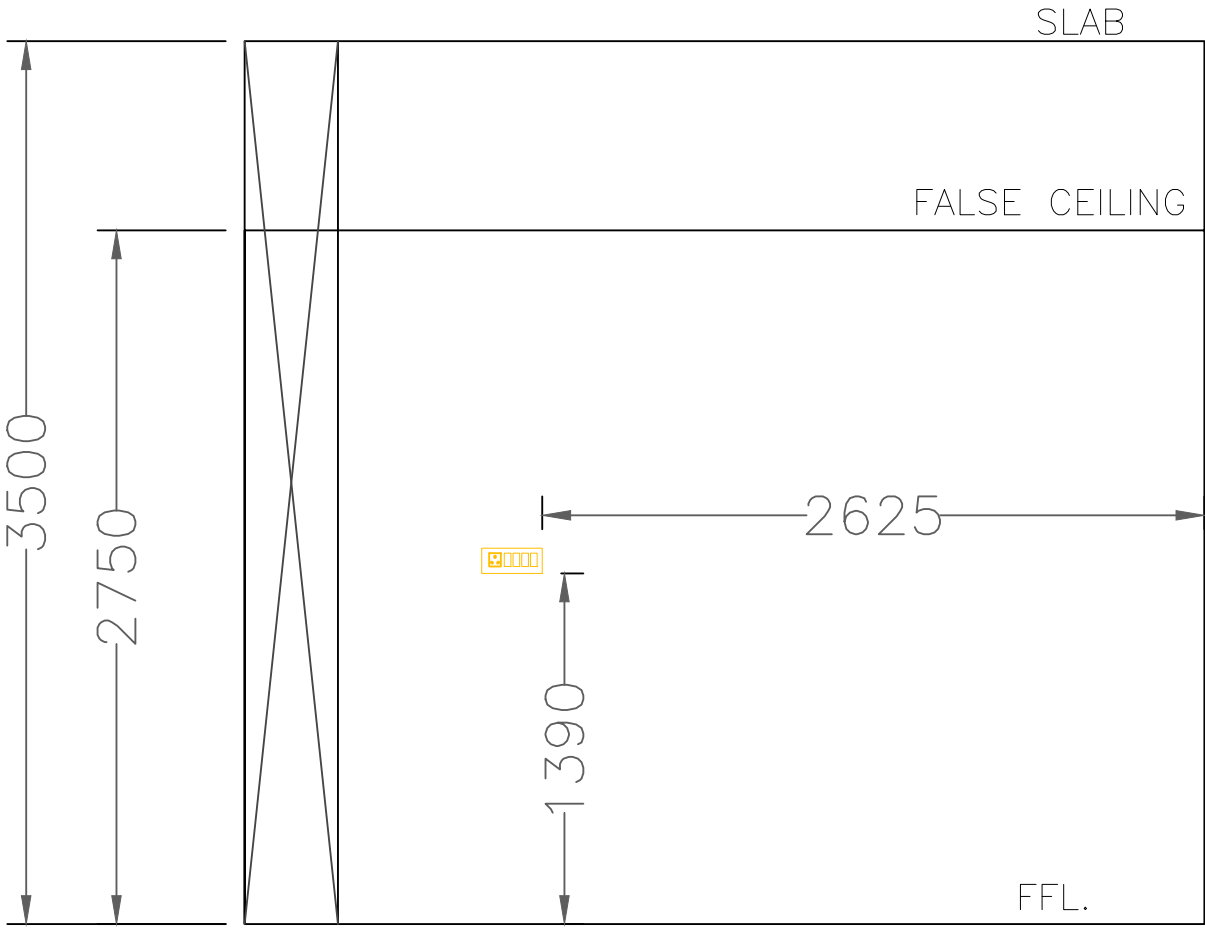

ELEVATION-3

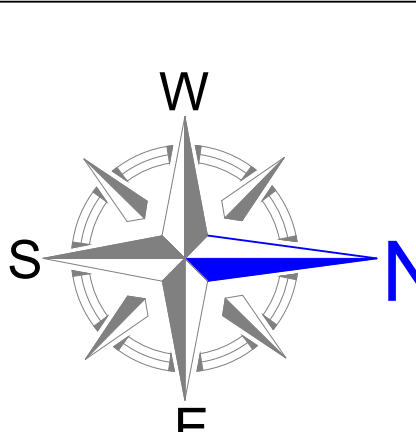

ELEVATION-4

	TITLE :	CLIENT :			PROJECT :	
	AUTOCLAVE ROOM CORRIDOR ELEVATION LAYOUT	TELANGANA STATE MEDICAL SERVICES AND INFRASTRUCTURE DEVELOPMENT CORPORATION.			IFV CENTER ON SECOND FLOOR IN MOTHER & CHILD HOSPITAL BUILDING BESIDE GANDHI HOSPITAL , SECUNDERABAD ,TELANGANA.	
	PURPOSE OF DRAWING :-	DWG. No.:			CONTRACTOR :	
	PROPOSED <input type="checkbox"/> FOR APPROVAL <input type="checkbox"/>	AVC/TGMSIDC/IVFP/S/13			<div>M/s Asta Vardhman Consortium H. NO. 8-2-334/27, Plot No. 27, Road No. 03, Banjara Hills, Hyderabad - 500034</div>	
	WORKING <input type="checkbox"/> AS BUILT <input checked="" type="checkbox"/>	REV	R1	DATE	17-06-2024	
	SCALE	NTS	SHEET	13		