




PLAN

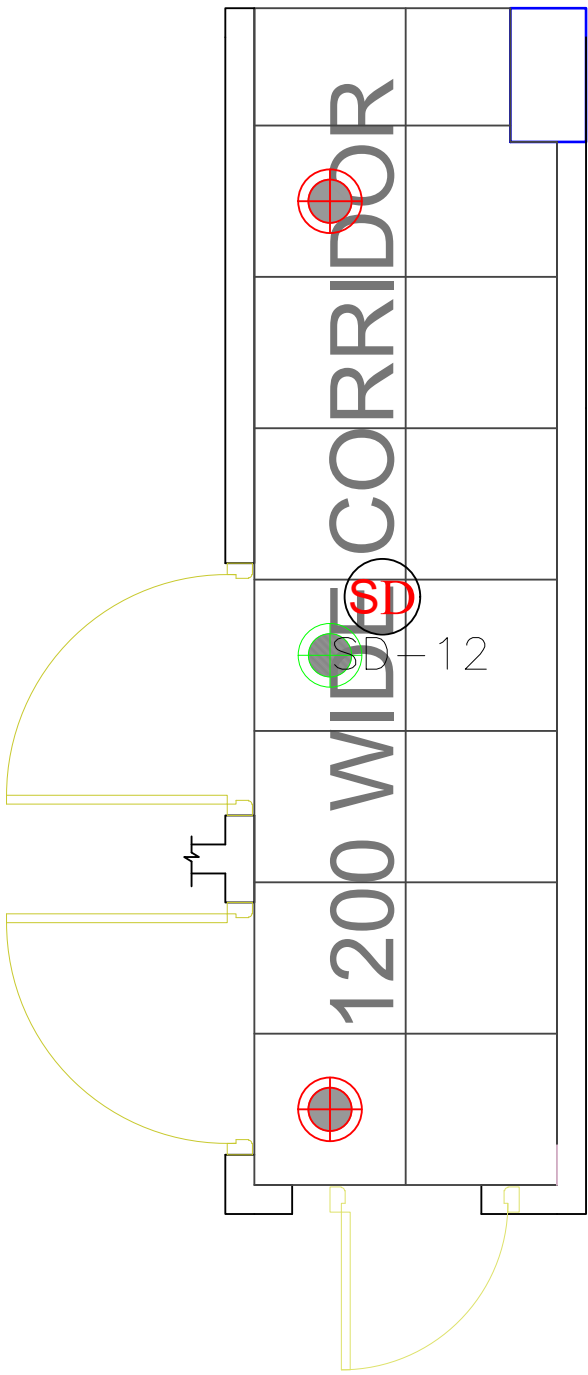


RCP

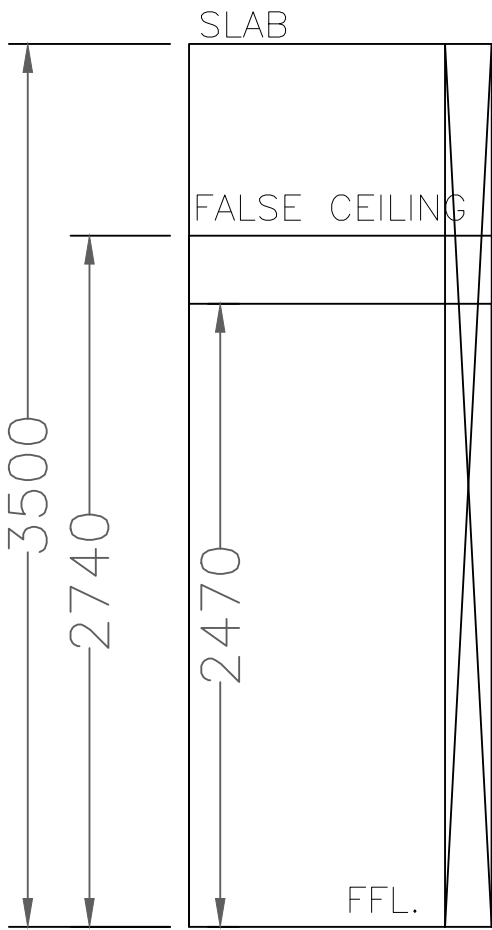


ELEVATION-1

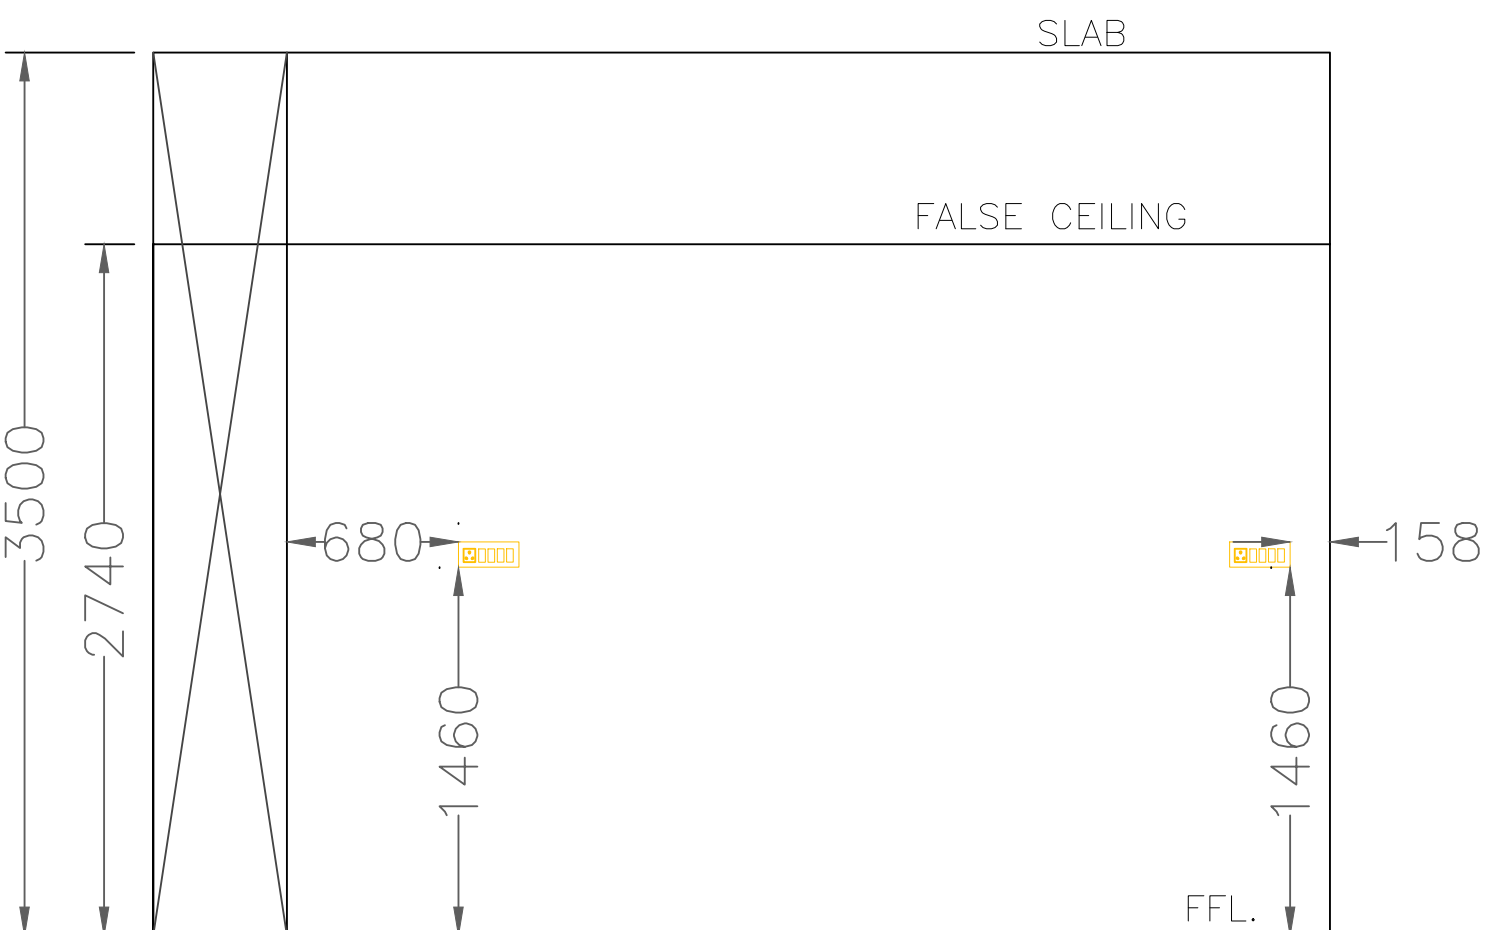

ELEVATION-2

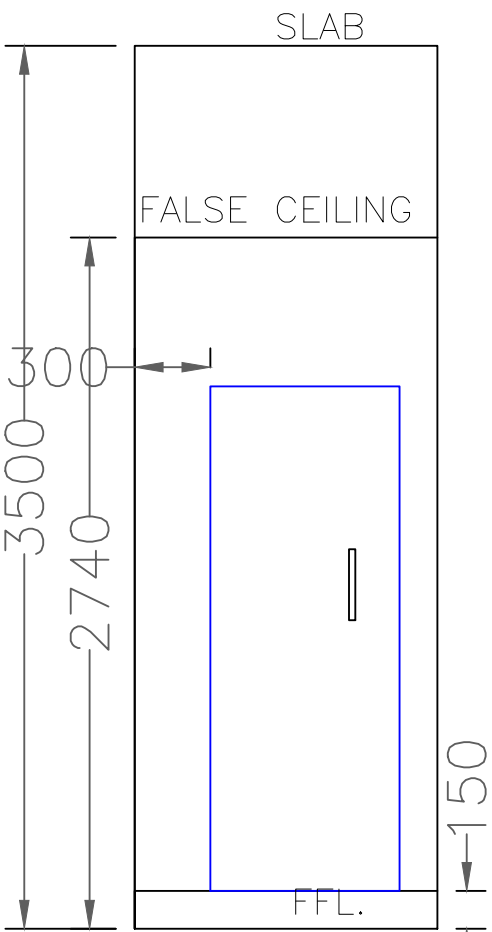

ELEVATION-3

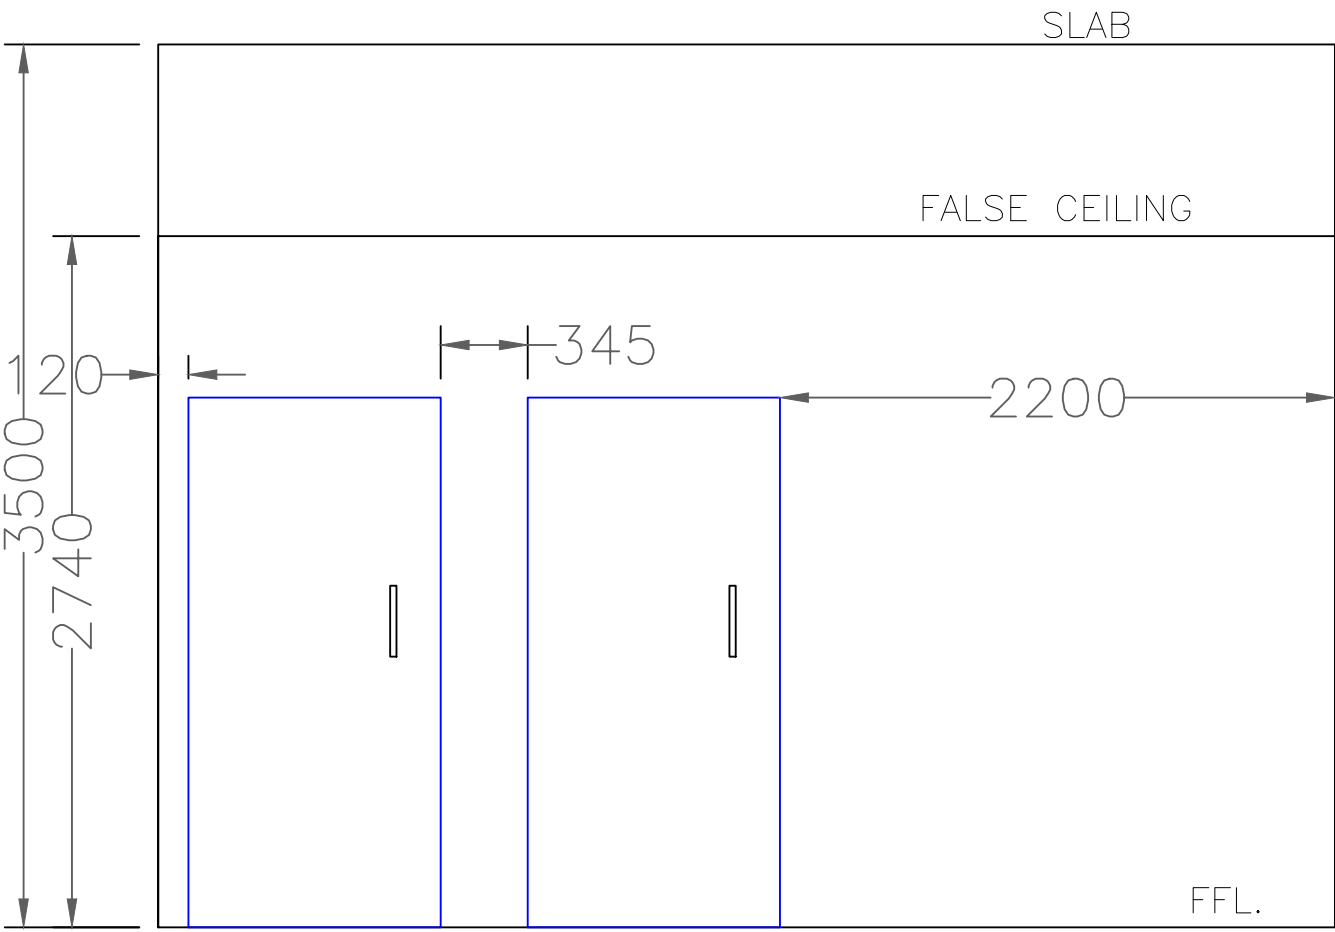

ELEVATION-4

	TITLE :	CLIENT :	PROJECT :
	EMBRYOLOGIST ROOM CORRIDOR ELEVATION LAYOUT	TELANGANA STATE MEDICAL SERVICES AND INFRASTRUCTURE DEVELOPMENT CORPORATION.	IFV CENTER ON SECOND FLOOR IN MOTHER & CHILD HOSPITAL BUILDING BESIDE GANDHI HOSPITAL , SECUNDERABAD ,TELANGANA.
	PURPOSE OF DRAWING :- PROPOSED <input type="checkbox"/> FOR APPROVAL <input type="checkbox"/> WORKING <input type="checkbox"/> AS BUILT <input checked="" type="checkbox"/>	DWG. No.: AVC/TGMSIDC/IVFP/S/28	CONTRACTOR : M/s Asta Vardhman Consortium H. NO. 8-2-334/27, Plot No. 27, Road No. 03, Banjara Hills, Hyderabad - 500034
		REV R1 DATE 17-06-2024 SCALE NTS SHEET 28	