




PLAN

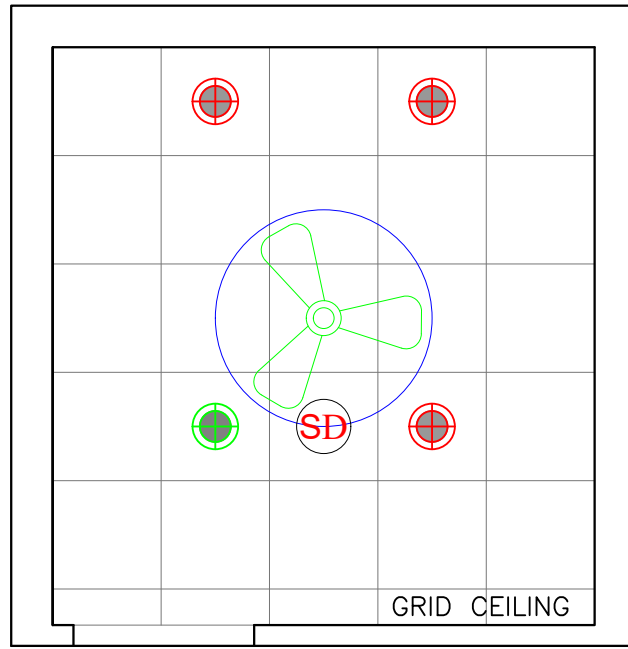


RCP PLAN

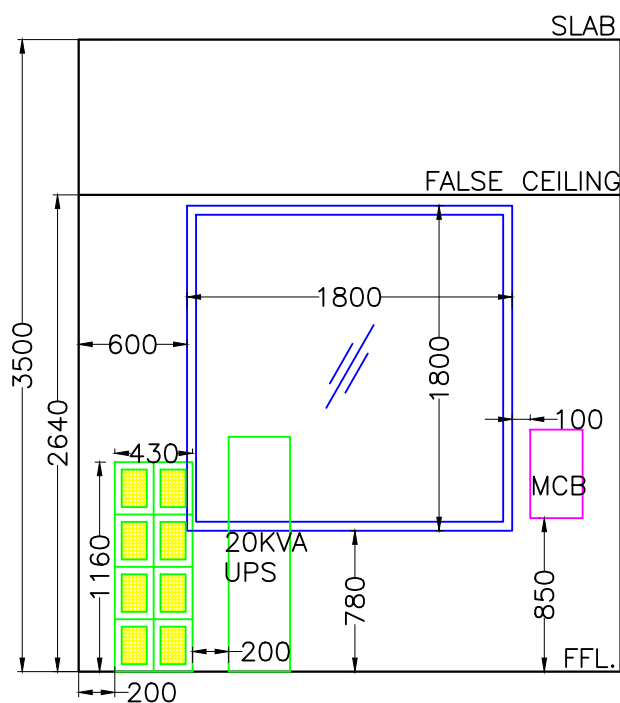


ELEVATION-1

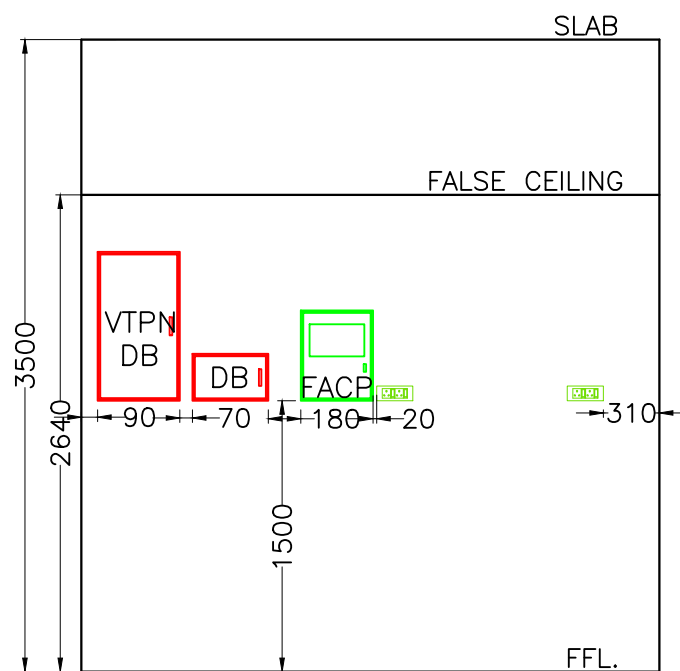


ELEVATION-2

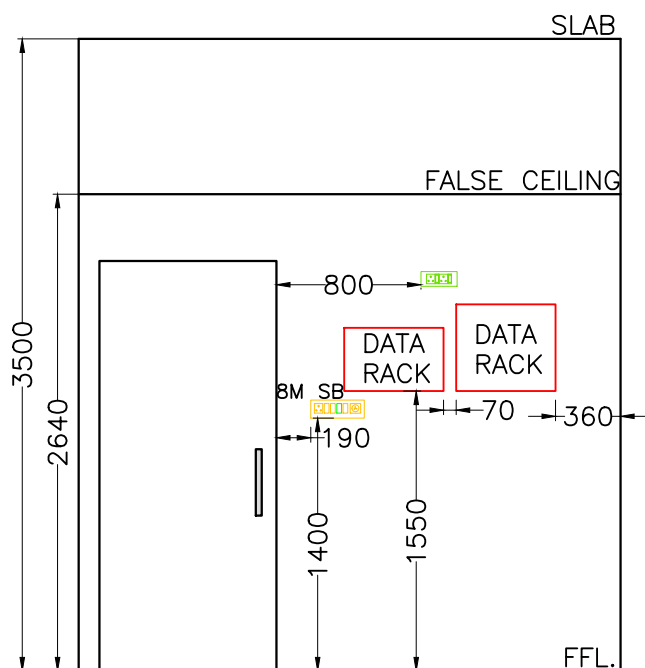

ELEVATION-3

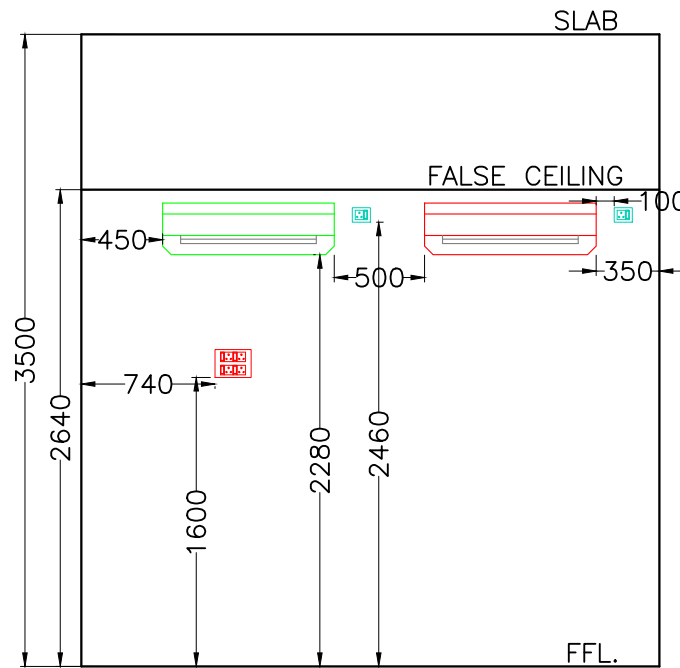

ELEVATION-4

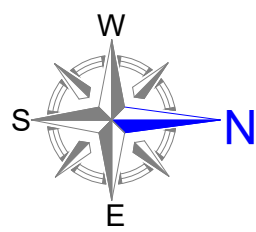

<p>TITLE :</p> <p>UPS ROOM ELEVATION LAYOUT</p> <p>PURPOSE OF DRAWING :-</p> <p>PROPOSED <input type="checkbox"/> FOR APPROVAL <input type="checkbox"/></p> <p>WORKING <input type="checkbox"/> AS BUILT <input checked="" type="checkbox"/></p>	CLIENT :			PROJECT :	
	<p>TELANGANA STATE MEDICAL SERVICES AND INFRASTRUCTURE DEVELOPMENT CORPORATION.</p>			<p>IFV CENTER ON SECOND FLOOR IN MOTHER & CHILD HOSPITAL BUILDING BESIDE GANDHI HOSPITAL , SECUNDERABAD , TELANGANA.</p>	
	<p>DWG. No.:</p> <p>AVC/TGMSIDC/IVFG/S/02</p>			<p>CONTRACTOR :</p>	
	REV	R5	DATE	20-06-2024	
	SCALE	NTS	SHEET	14	



M/s Asta Vardhman Consortium
H. NO. 8-2-334/27, Plot No. 27,
Road No. 03, Banjara Hills,
Hyderabad - 500034

