




PLAN

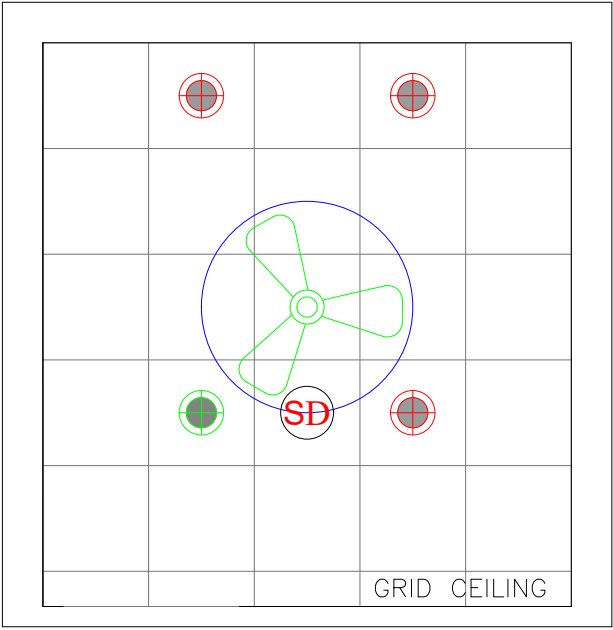


RCP PLAN

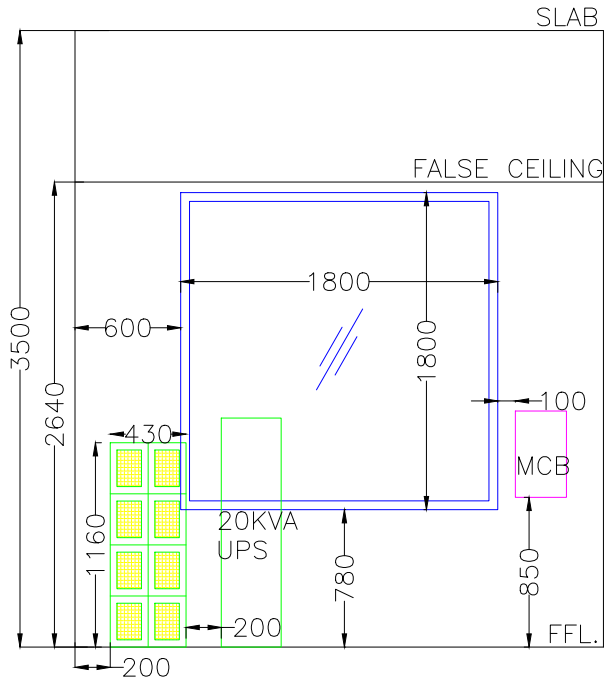


ELEVATION-1

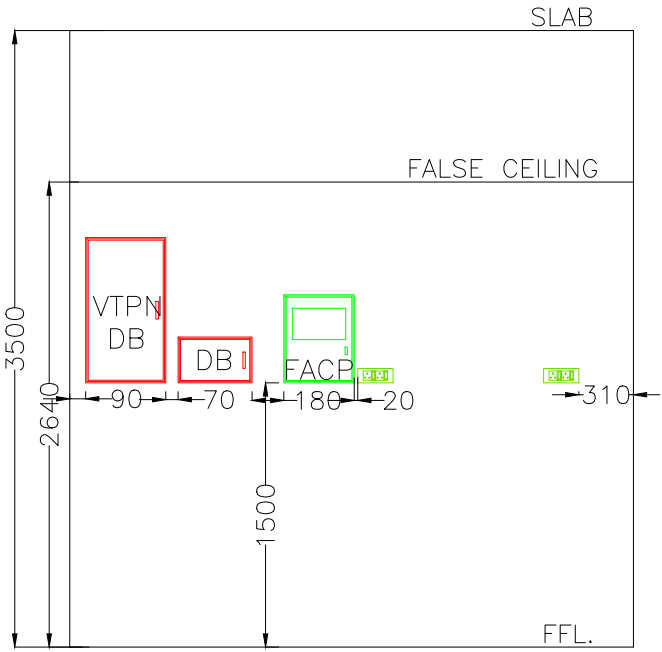

ELEVATION-2

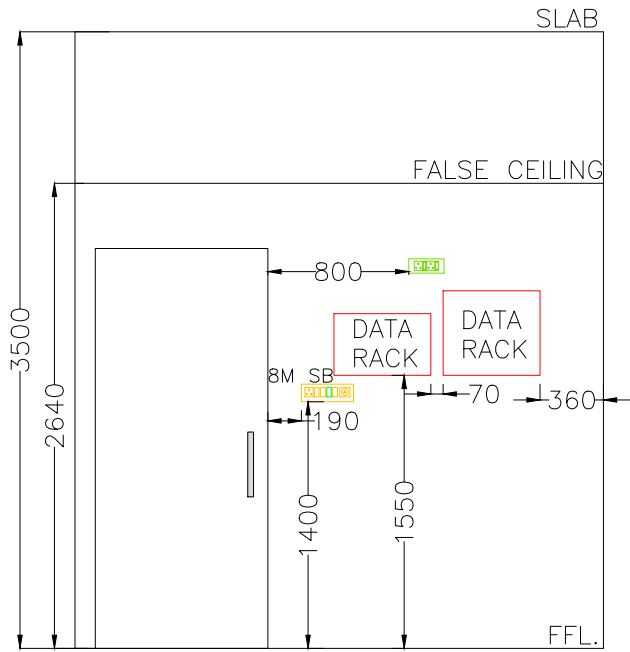

ELEVATION-3

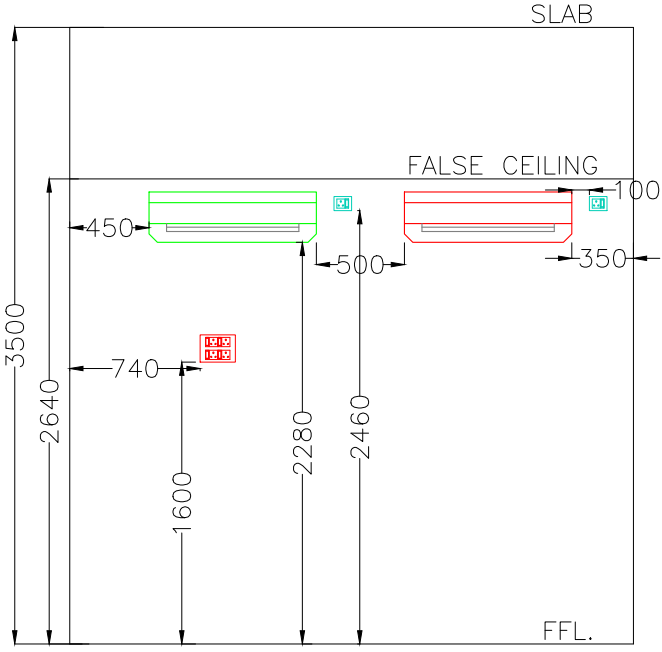

ELEVATION-4

	TITLE :	CLIENT :	PROJECT :
	UPS ROOM ELEVATION LAYOUT	TELANGANA STATE MEDICAL SERVICES AND INFRASTRUCTURE DEVELOPMENT CORPORATION.	IFV CENTER ON SECOND FLOOR IN MOTHER & CHILD HOSPITAL BUILDING BESIDE GANDHI HOSPITAL , SECUNDERABAD ,TELANGANA.
	PURPOSE OF DRAWING :-	DWG. No.:	CONTRACTOR :
	PROPOSED <input type="checkbox"/> FOR APPROVAL <input type="checkbox"/> WORKING <input type="checkbox"/> AS BUILT <input checked="" type="checkbox"/>	AVC/TGMSIDC/IVFG/S/02 REV R4 DATE 04-06-2024 SCALE NTS SHEET 14	 M/s Asta Vardhman Consortium H. NO. 8-2-334/27, Plot No. 27, Road No. 03, Banjara Hills, Hyderabad - 500034