




PLAN

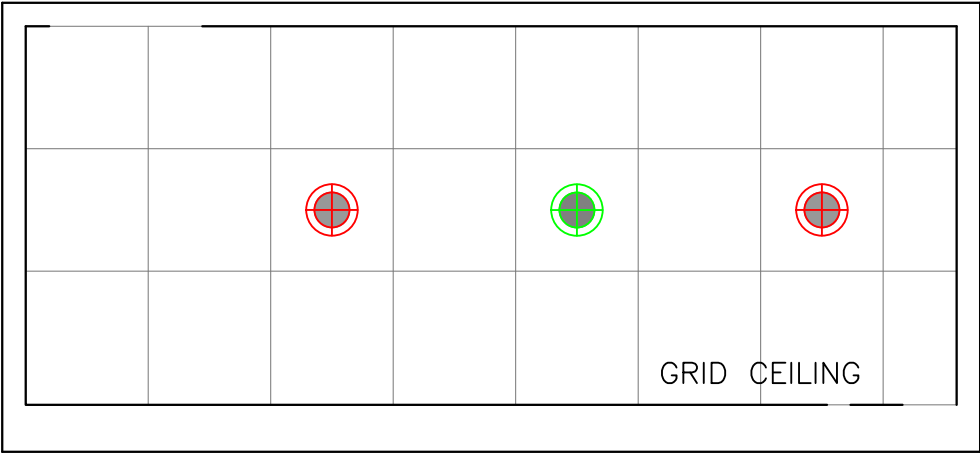


RCP PLAN

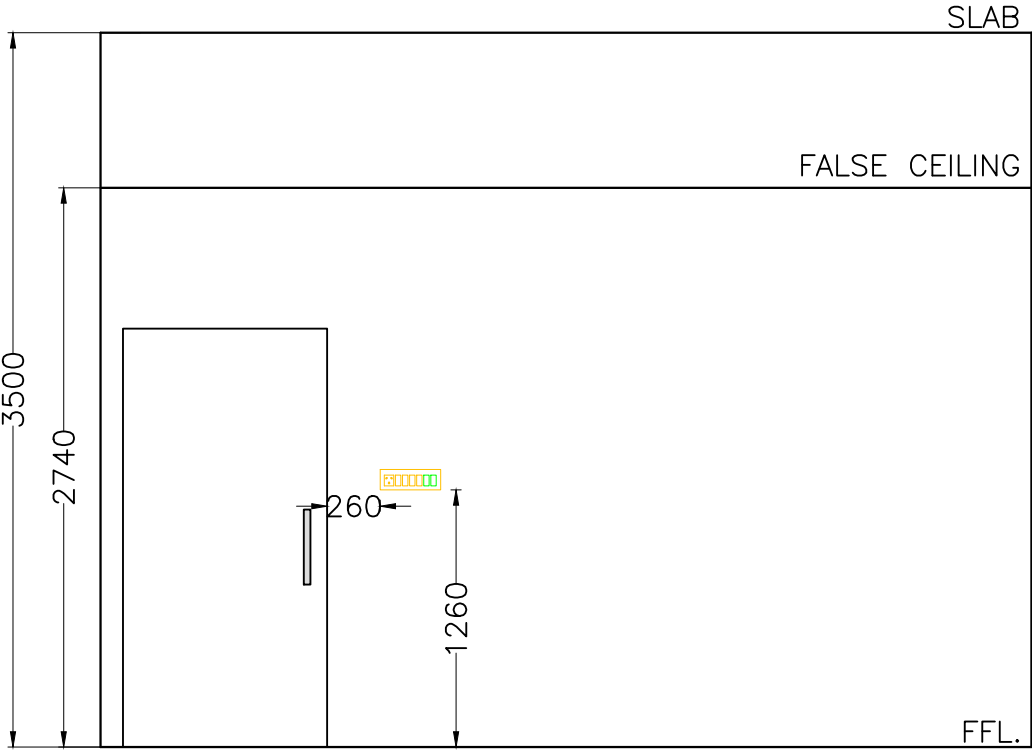


ELEVATION-1

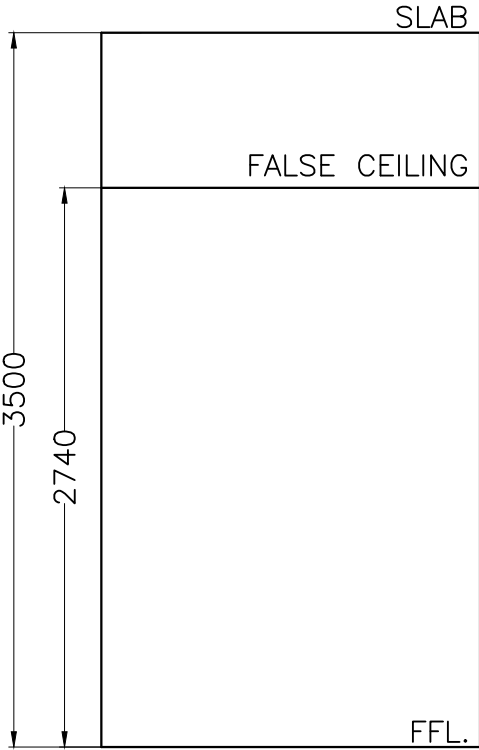


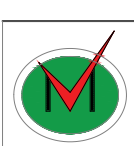
ELEVATION-2

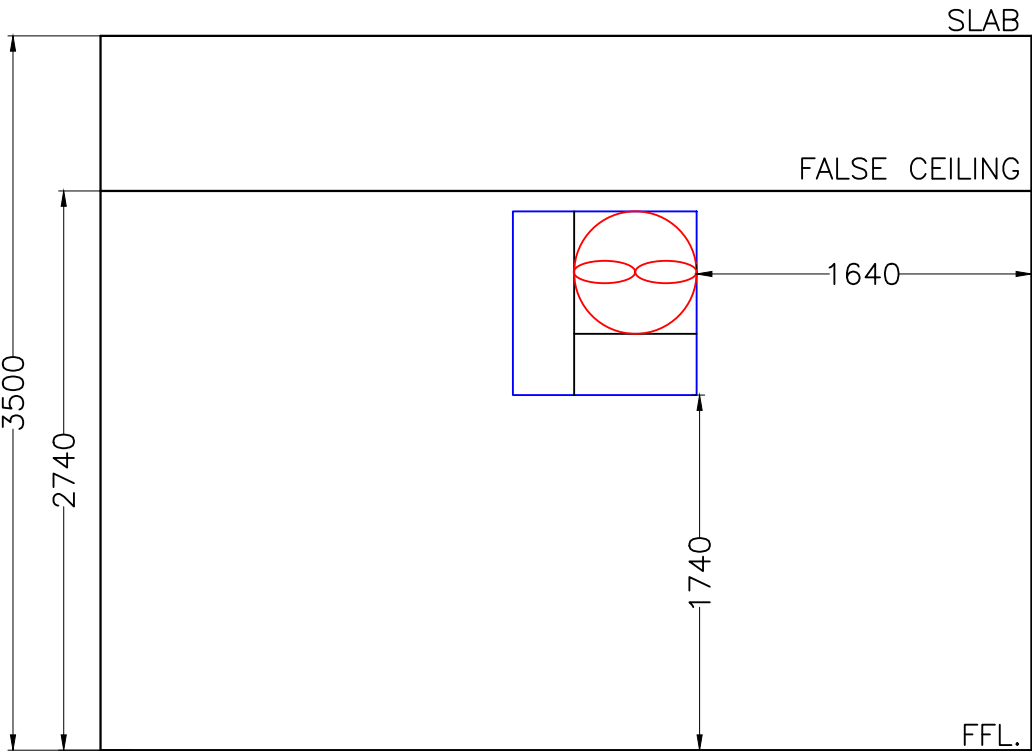

ELEVATION-3

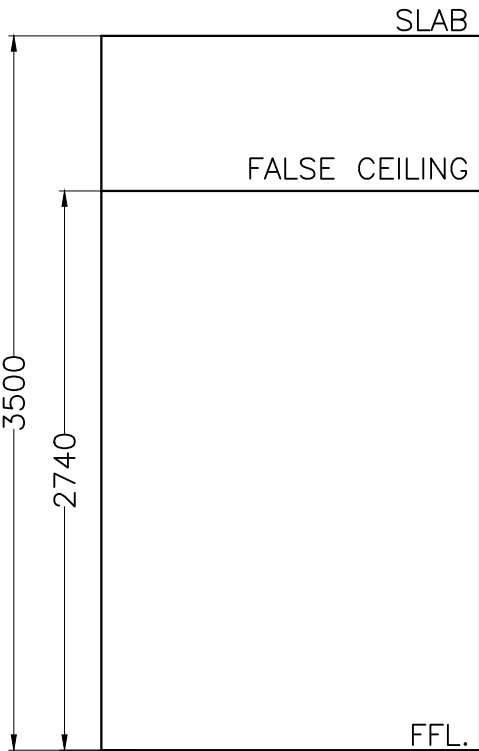

ELEVATION-4

	TITLE :	CLIENT :			PROJECT :	
	DR. TOILET ELEVATION LAYOUT	TELANGANA STATE MEDICAL SERVICES AND INFRASTRUCTURE DEVELOPMENT CORPORATION.			IFV CENTER ON SECOND FLOOR IN MOTHER & CHILD HOSPITAL BUILDING BESIDE GANDHI HOSPITAL , SECUNDERABAD ,TELANGANA.	
	PURPOSE OF DRAWING :-	DWG. No.:			CONTRACTOR :	
	PROPOSED <input type="checkbox"/> FOR APPROVAL <input type="checkbox"/>	AVC/TGMSIDC/IVFG/S/09			<div><div>M/s Asta Vardhman Consortium H. NO. 8-2-334/27, Plot No. 27, Road No. 03, Banjara Hills, Hyderabad - 500034</div></div>	
WORKING <input type="checkbox"/> AS BUILT <input checked="" type="checkbox"/>	REV	R5	DATE	20-06-2024		
	SCALE	NTS	SHEET	21		