




PLAN

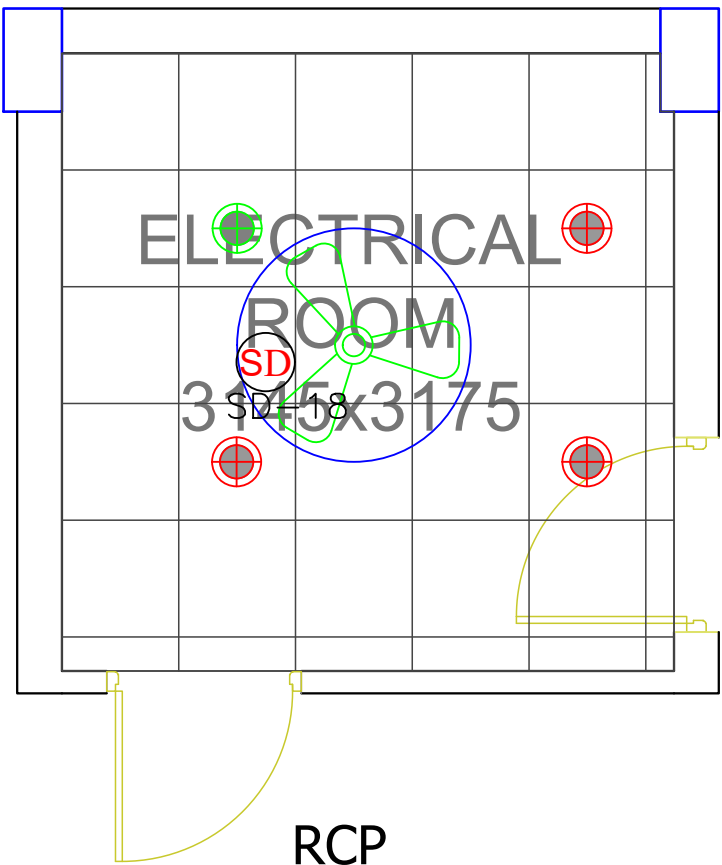


RCP

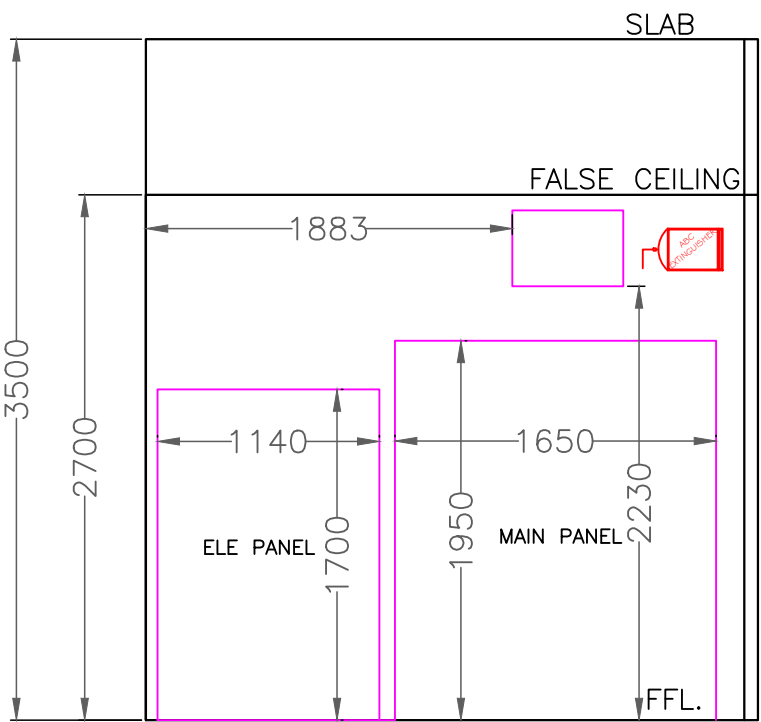


ELEVATION-1

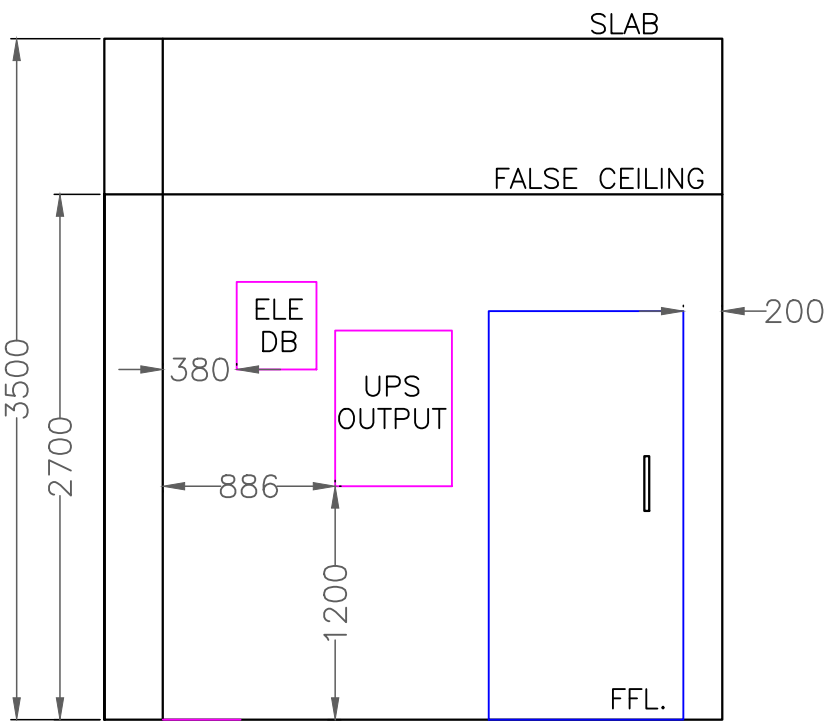


ELEVATION-2

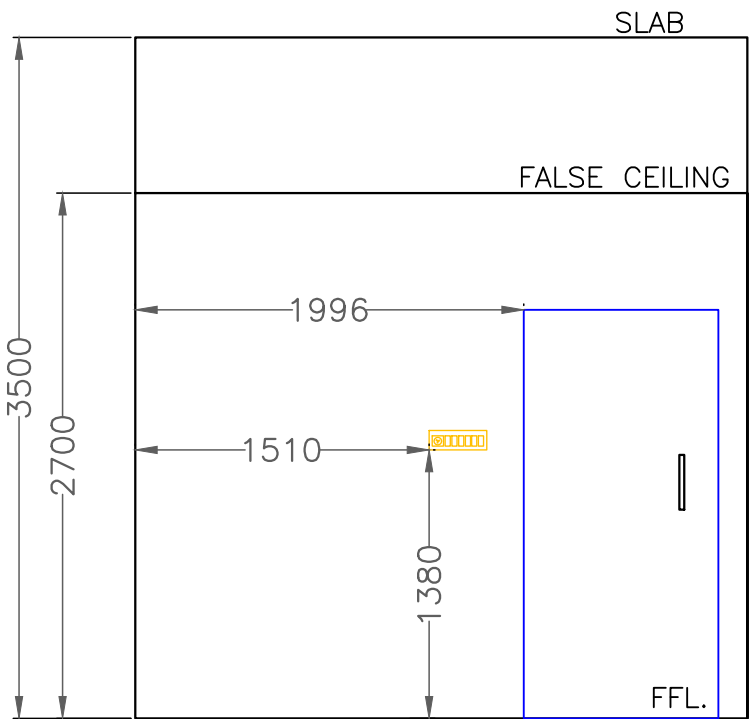

ELEVATION-3

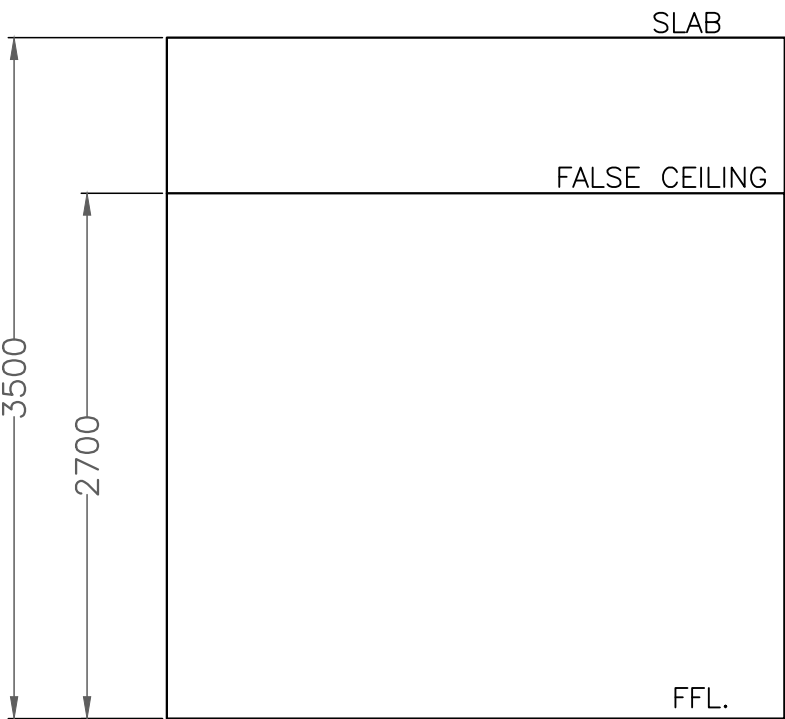

ELEVATION-4

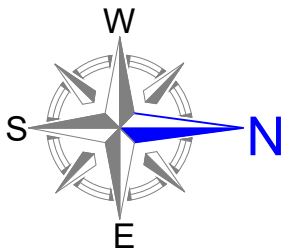

TITLE :
**ELECTRICAL ROOM
ELEVATION LAYOUT**


PURPOSE OF DRAWING :-
PROPOSED ☐ **FOR APPROVAL** ☐
WORKING ☐ **AS BUILT** ☒

CLIENT :
TELANGANA STATE MEDICAL
SERVICES AND INFRASTRUCTURE
DEVELOPMENT CORPORATION.

DWG. No.:
AVC/TGMSIDC/IVFP/S/18

REV	R2	DATE	20-06-2024
SCALE	NTS	SHEET	18

PROJECT :
IFV CENTER ON THIRD FLOOR IN MODERN
GOVERNMENT MATERNITY HOSPITAL,
PETLABURJ, HYDERABAD ,TELANGANA.

CONTRACTOR :
 M/s Asta Vardhman Consortium
H. NO. 8-2-334/27, Plot No. 27,
Road No. 03, Banjara Hills,
Hyderabad - 500034

