

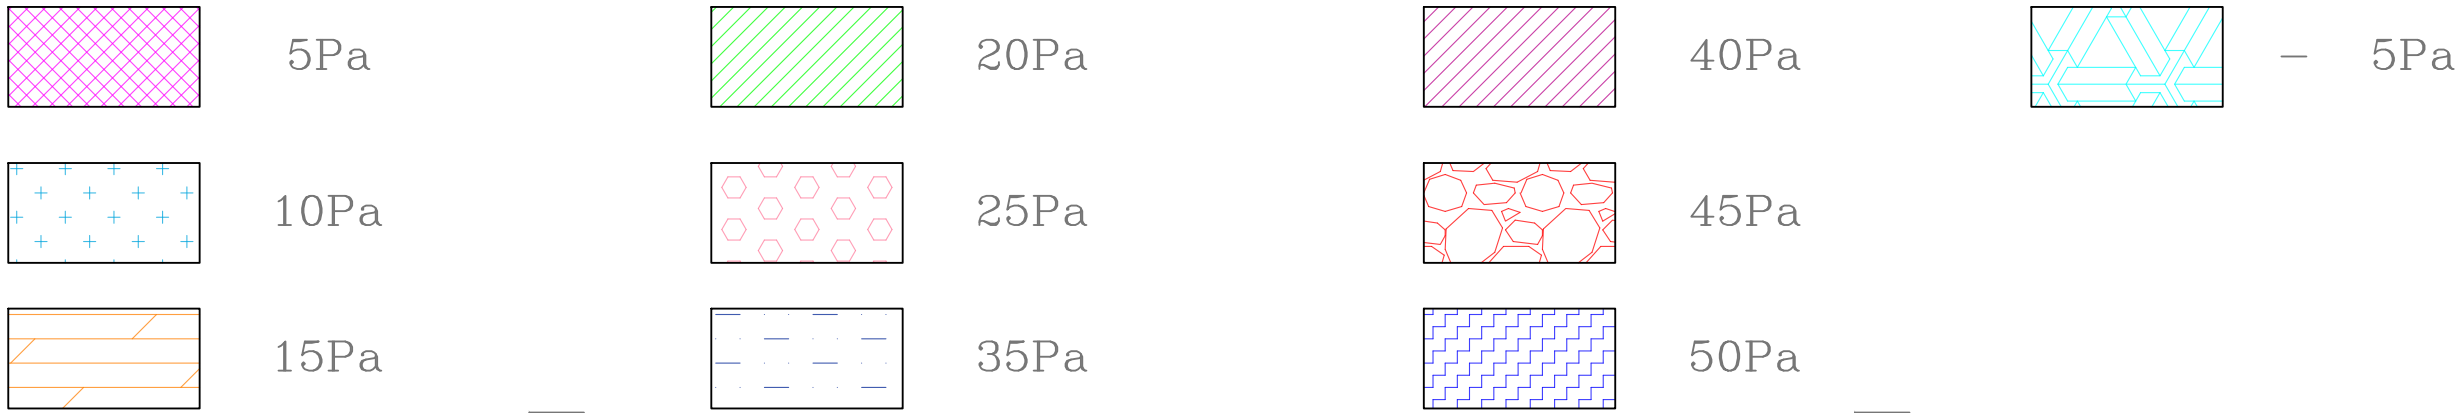


LEGEND:

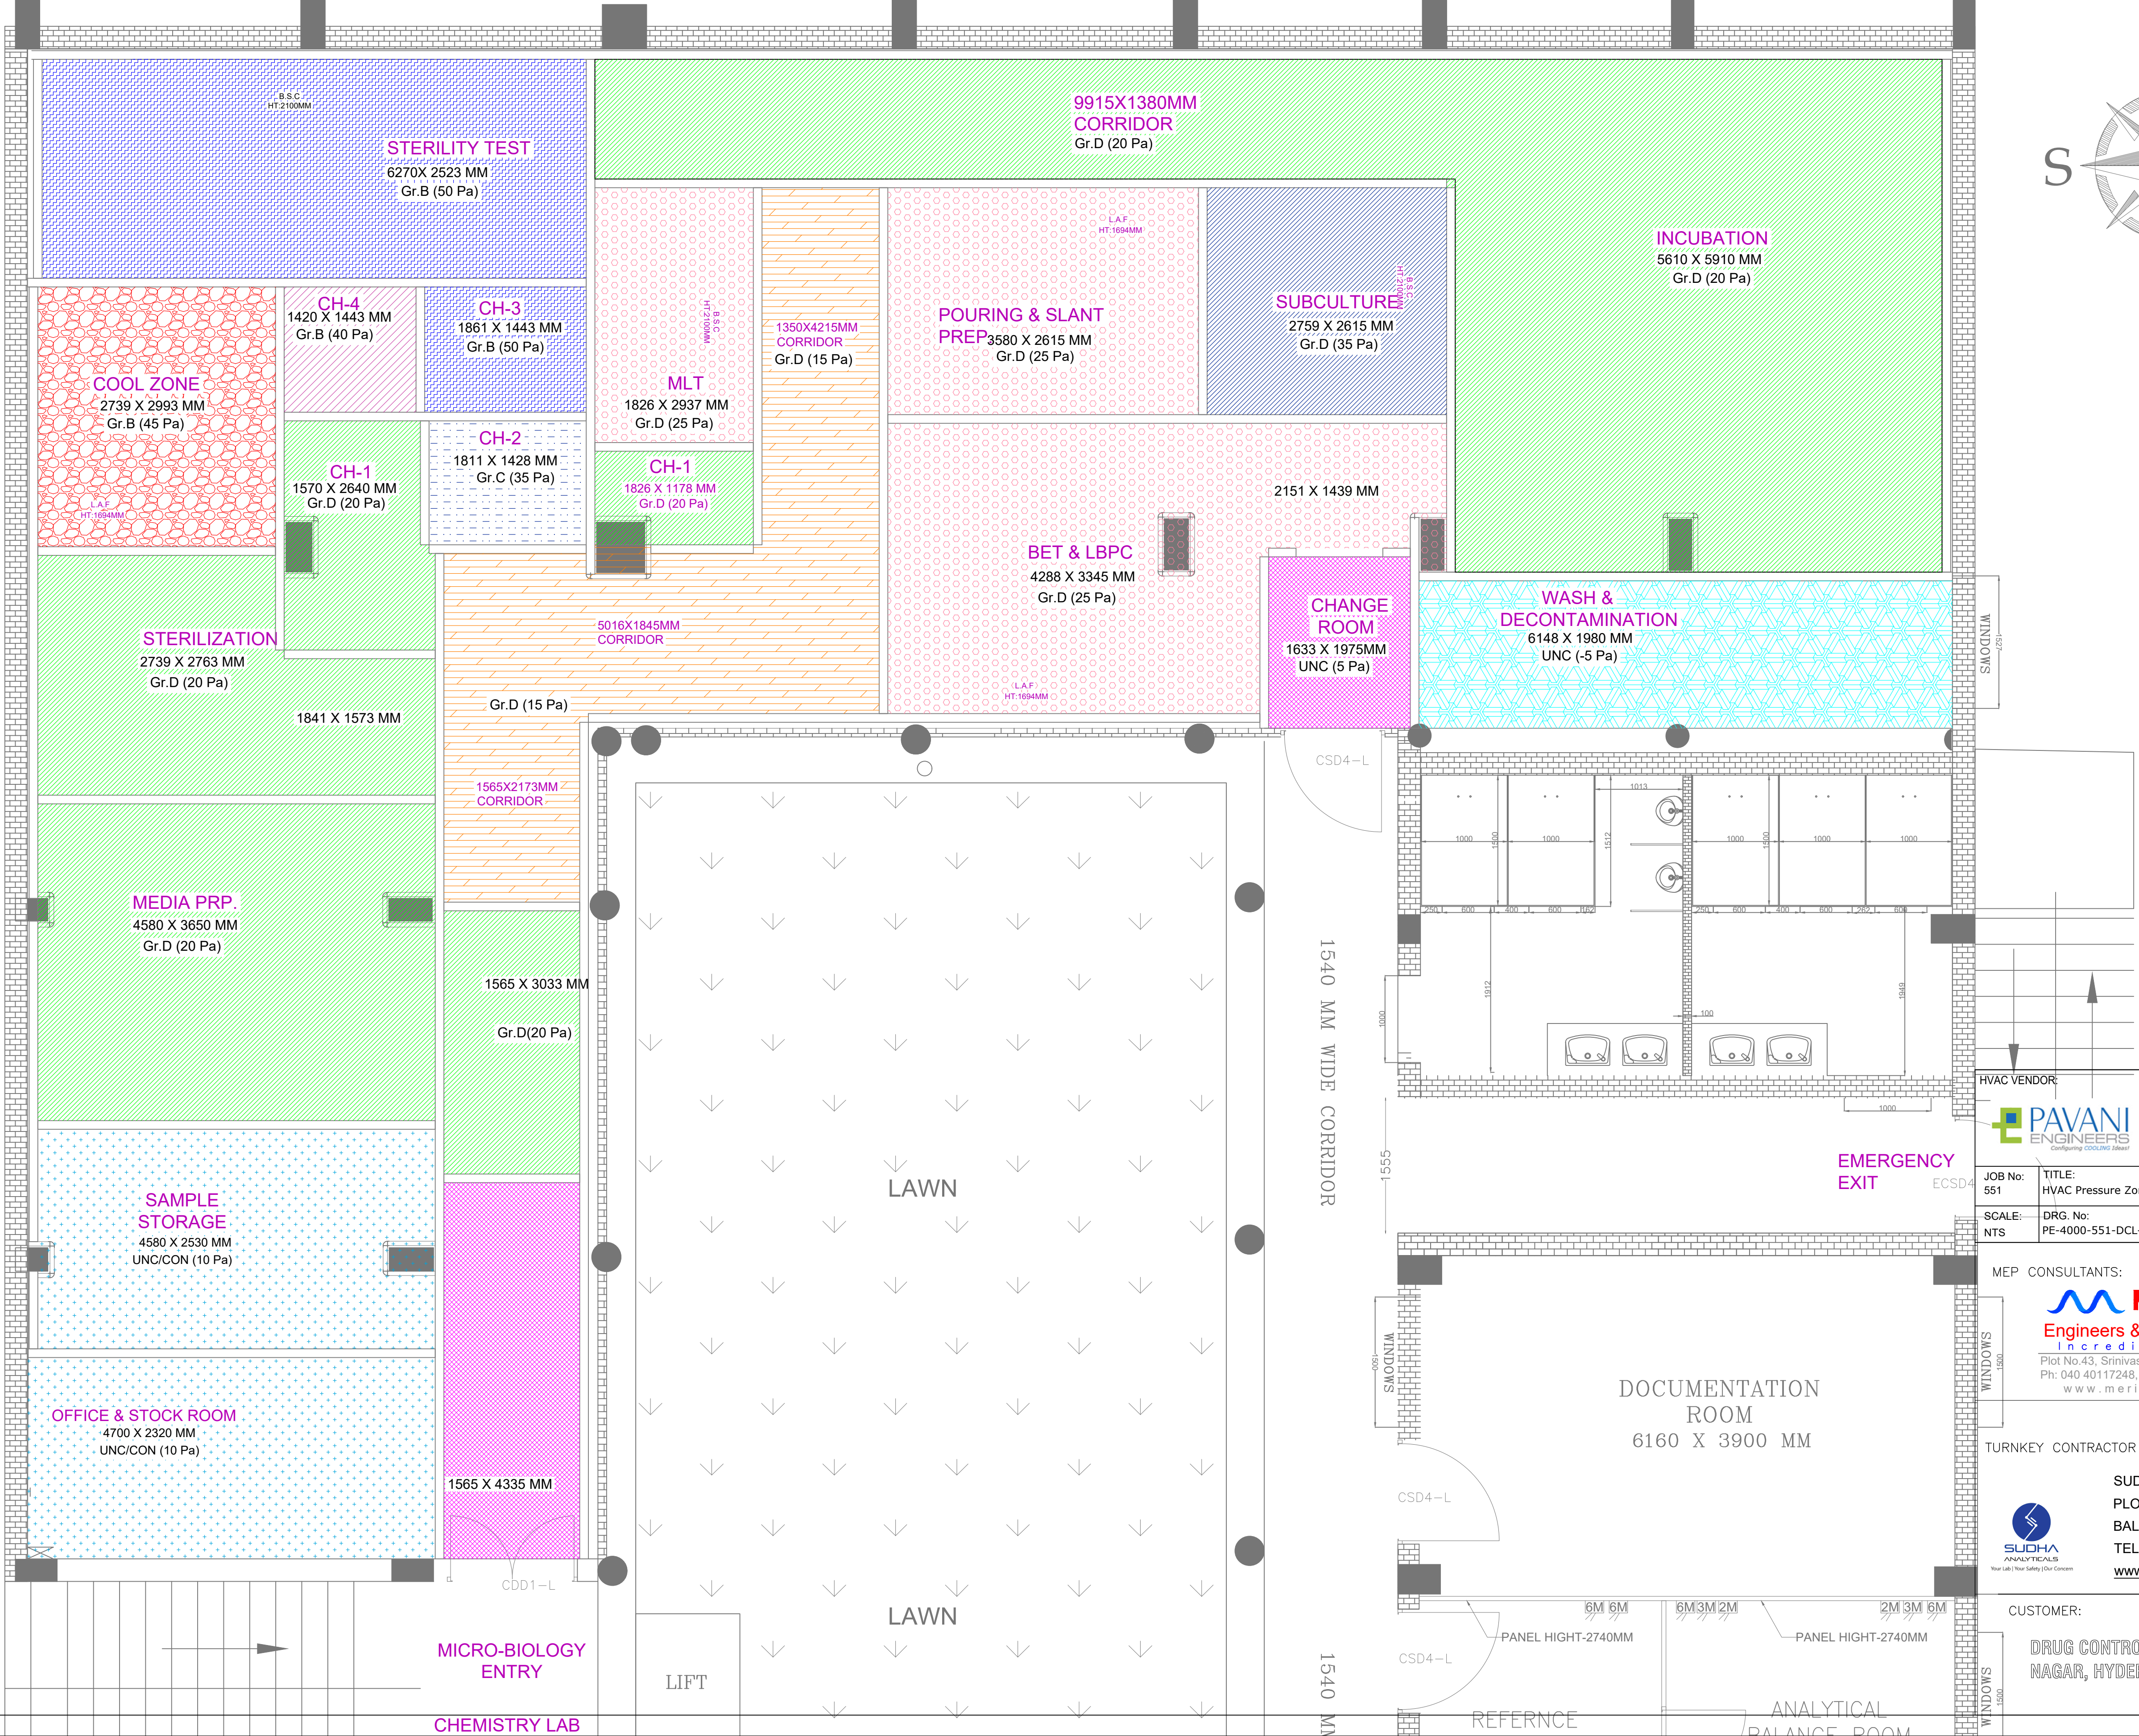

PRESSURE ZONING LAYOUT

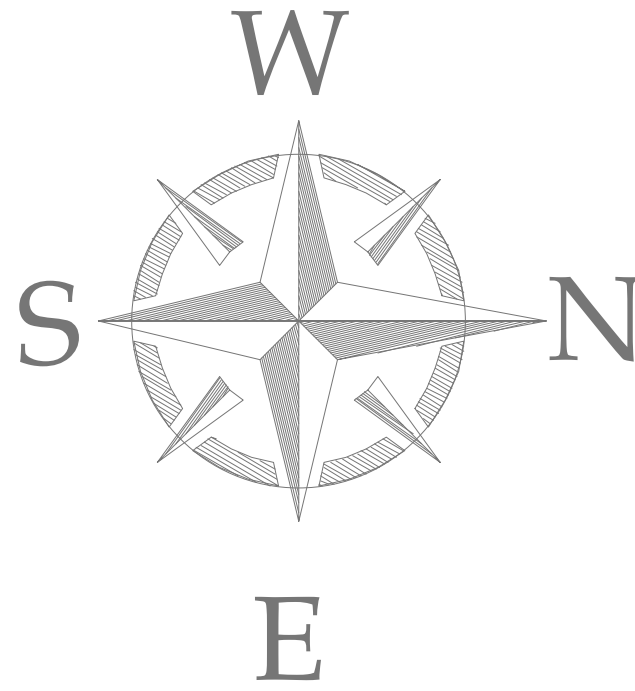

AS BUILT

PLOT NO. 26, IDA MALLAPUR, NACHARAM,  
HYDERABAD-500 076.  
Ph: 040-27176661, 27176662, 27176663  
E-mail: Pavanienigneers@gmail.com

JOB No: 551  
SCALE: NTS  
TITLE: HVAC Pressure Zoning Layout - Microbiology, First Floor, DCL.  
DRG. No: PE-4000-551-DCL-HVAC-PZL-AB

MEP CONSULTANTS:  
**MERIDIAN**  
Engineers & Consultancy Services  
Incredible innovation  
Plot No.43, Srinivasa Colony (West), Hyderabad 500 038  
Ph: 040 40117248, E Mail : contact@meridianmep.com  
www.meridianmep.com

TURNKEY CONTRACTOR  
**SUDHA ANALYTICALS**  
SY. NO. 118,  
PLOT NO. 18 PART, IDA BALANAGAR,  
BALANAGAR, HYDERABAD - 500037  
TEL (+91) 40 23810902 / 906  
www.sudhaanalytics.com

CUSTOMER:  
**DRUG CONTROL LABORATORY, VENGALRAO  
NAGAR, HYDERABAD**