




PLAN

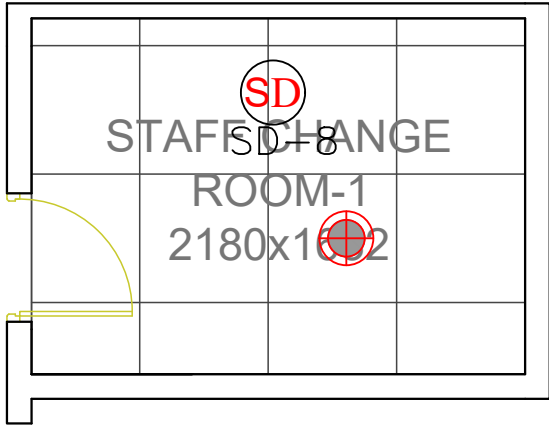


RCP

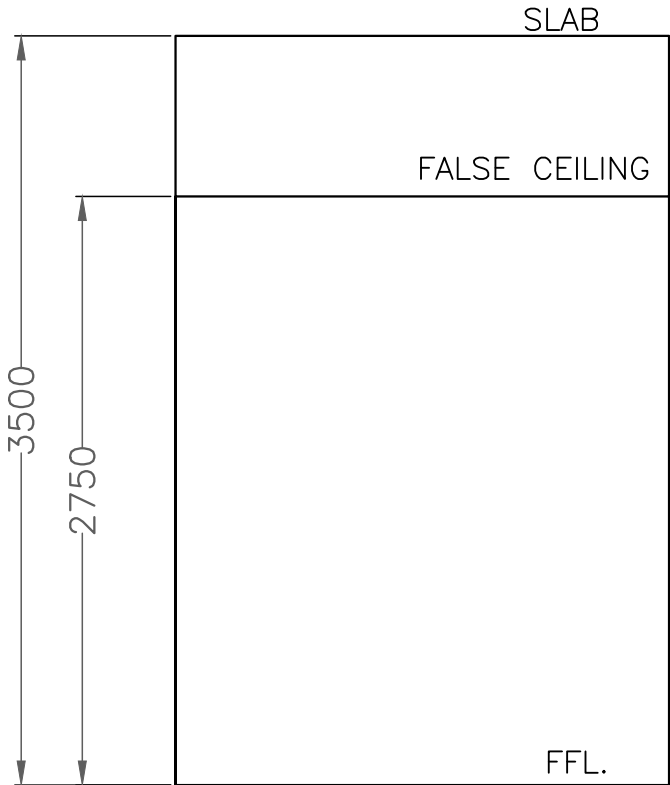


ELEVATION-1

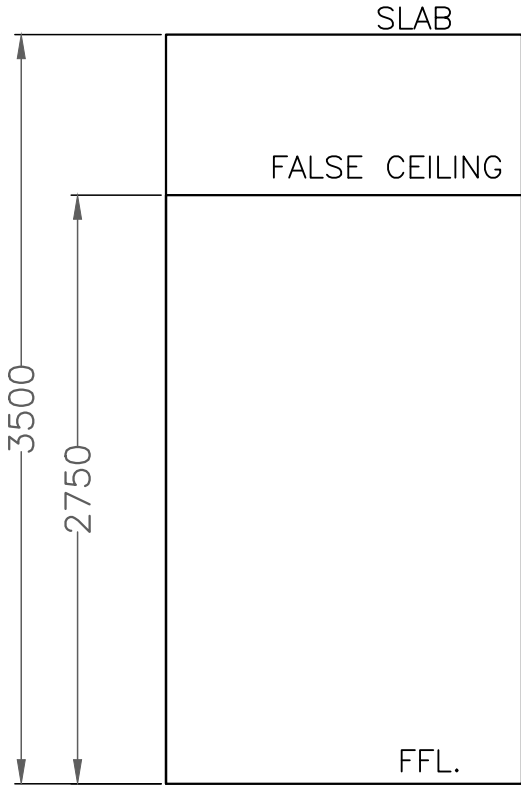

ELEVATION-2

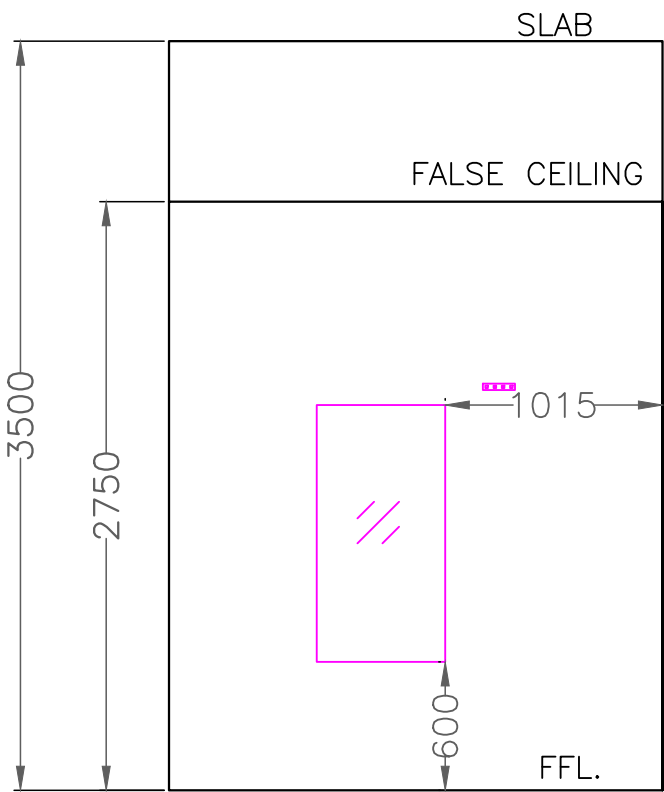

ELEVATION-3

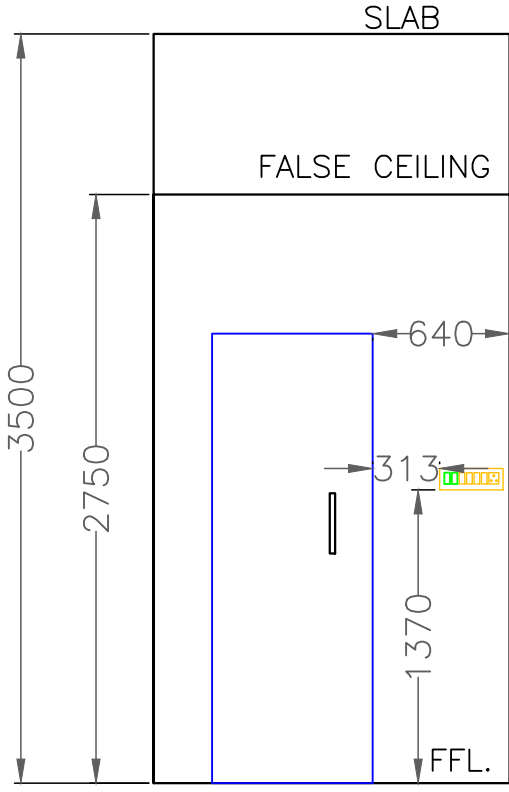

ELEVATION-4

	TITLE :	CLIENT :	PROJECT :
	STAFF CHANGE ROOM-1 ELEVATION LAYOUT	TELANGANA STATE MEDICAL SERVICES AND INFRASTRUCTURE DEVELOPMENT CORPORATION.	IFV CENTER ON THIRD FLOOR IN MODERN GOVERNMENT MATERNITY HOSPITAL, PETLABURJ, HYDERABAD ,TELANGANA.
	PURPOSE OF DRAWING :- PROPOSED <input type="checkbox"/> FOR APPROVAL <input type="checkbox"/> WORKING <input type="checkbox"/> AS BUILT <input checked="" type="checkbox"/>	DWG. No.: AVC/TGMSIDC/IVFP/S/33	CONTRACTOR :
		REV R2 DATE 20-06-2024	 M/s Asta Vardhman Consortium H. NO. 8-2-334/27, Plot No. 27, Road No. 03, Banjara Hills, Hyderabad - 500034
		SCALE NTS SHEET 33	