




PLAN

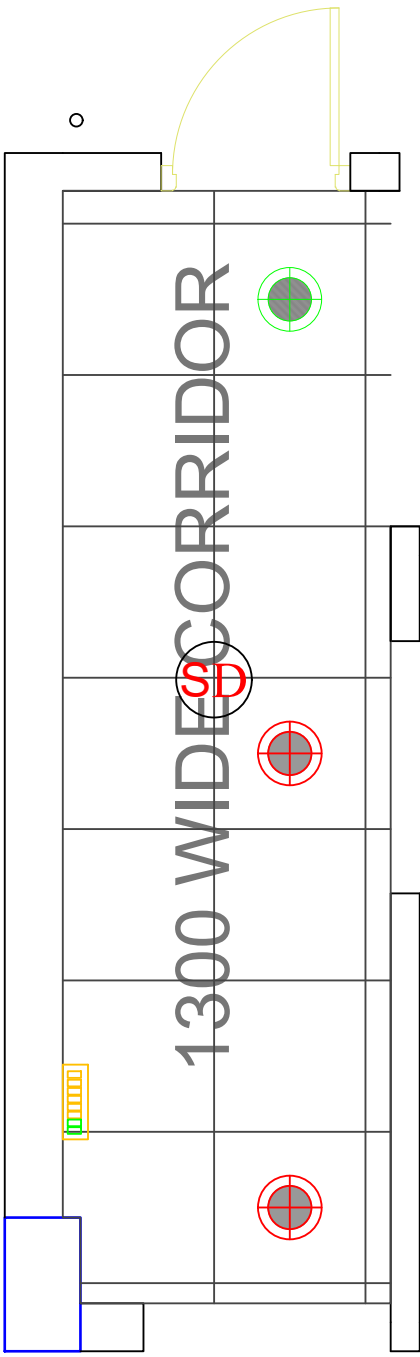


RCP

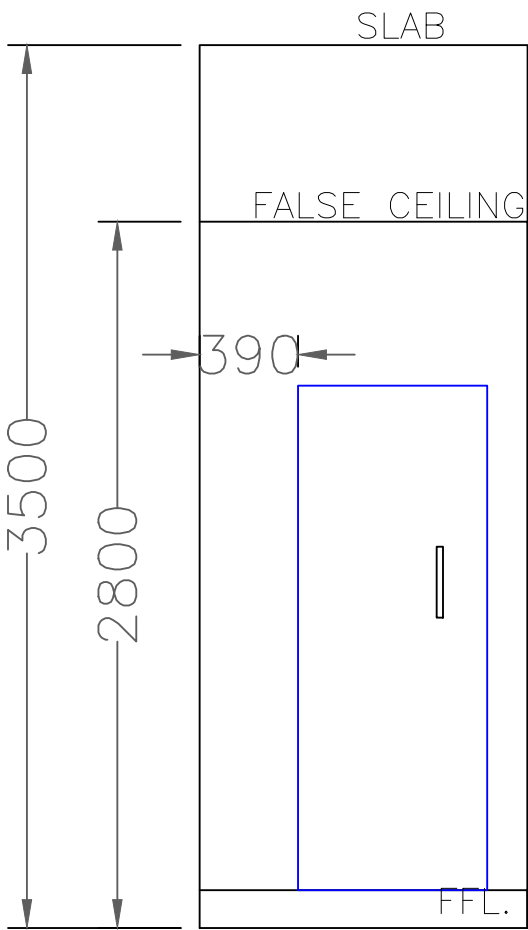


ELEVATION-1

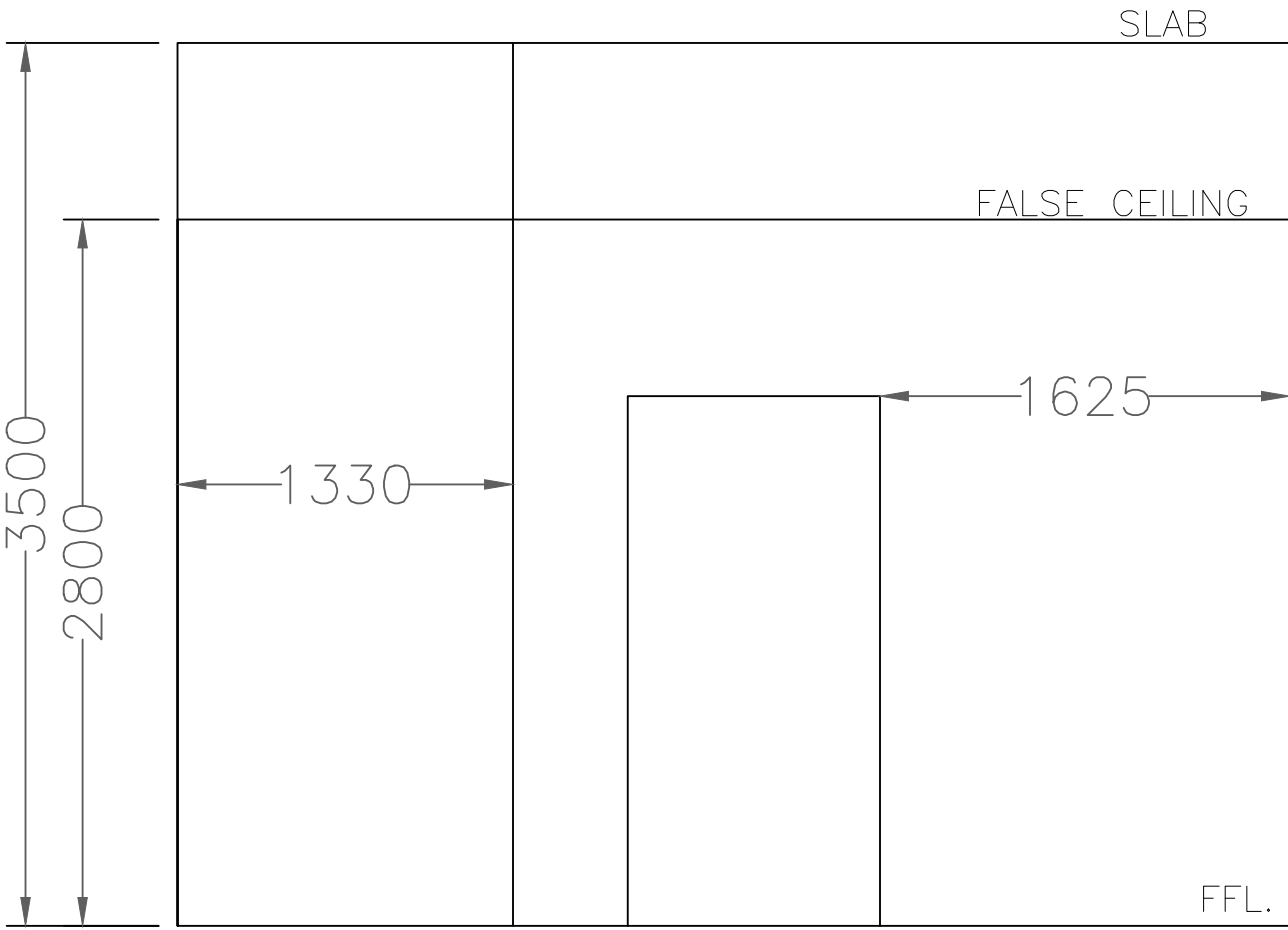


ELEVATION-2

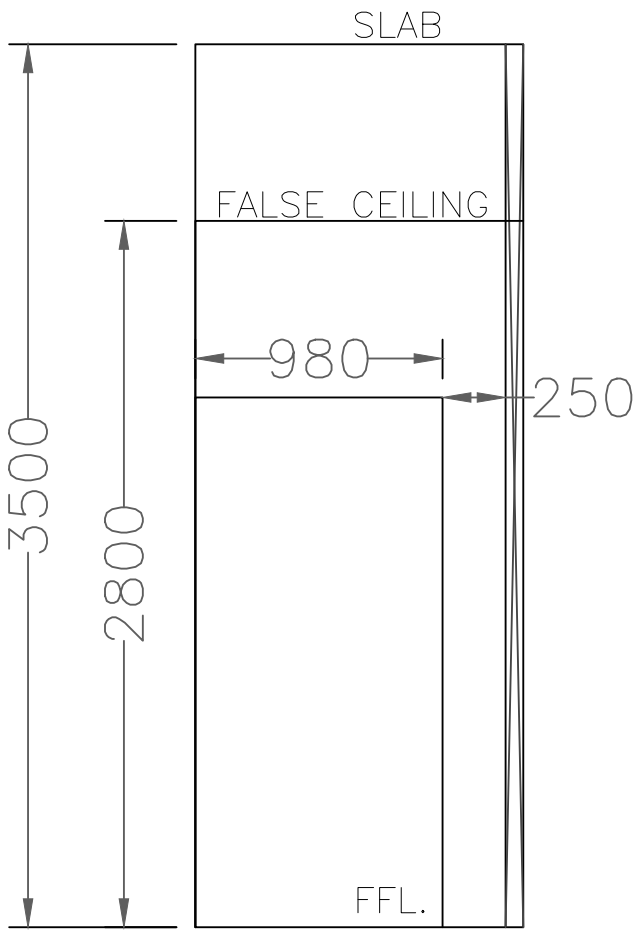
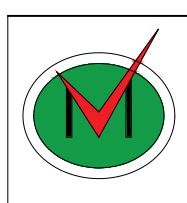


ELEVATION-3

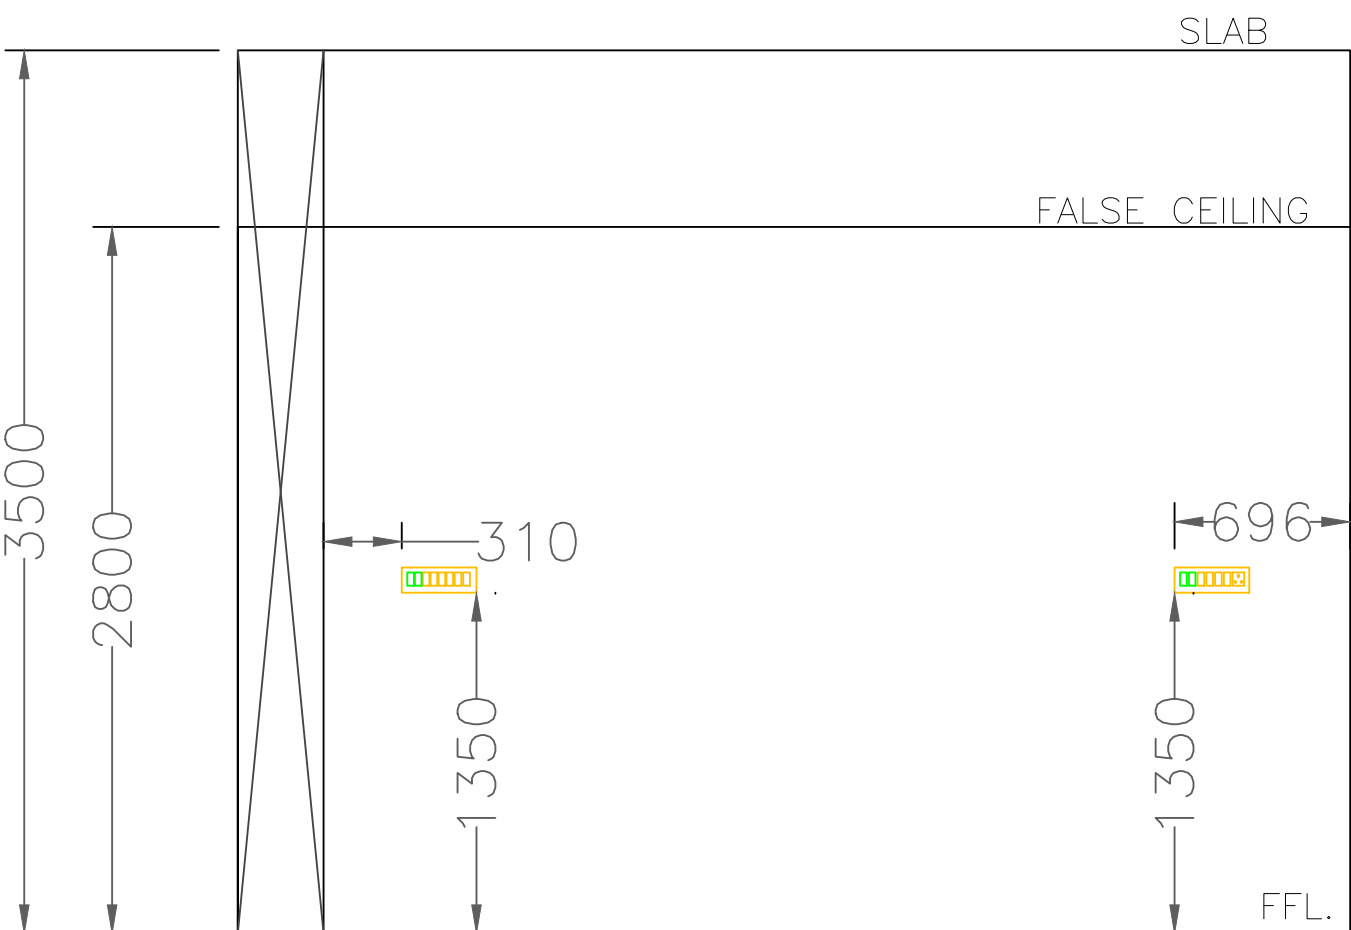

ELEVATION-4

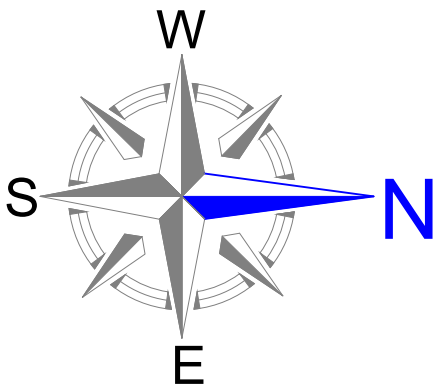

TITLE :		CLIENT :		PROJECT :	
DR CHANGE ROOMS CORRIDOR ELEVATION LAYOUT		TELANGANA STATE MEDICAL SERVICES AND INFRASTRUCTURE DEVELOPMENT CORPORATION.		IFV CENTER ON SECOND FLOOR IN MOTHER & CHILD HOSPITAL BUILDING BESIDE GANDHI HOSPITAL , SECUNDERABAD ,TELANGANA.	
PURPOSE OF DRAWING :-  PROPOSED <input type="checkbox"/> FOR APPROVAL <input type="checkbox"/>  WORKING <input type="checkbox"/> AS BUILT <input checked="" type="checkbox"/>		DWG. No.:  AVC/TGMSIDC/IVFP/S/05		CONTRACTOR :  <div><div><div>M/s Asta Vardhman Consortium H. NO. 8-2-334/27, Plot No. 27, Road No. 03, Banjara Hills, Hyderabad - 500034</div><div></div></div></div>	
		REV	R1	DATE	17-06-2024
		SCALE	NTS	SHEET	05