




PLAN

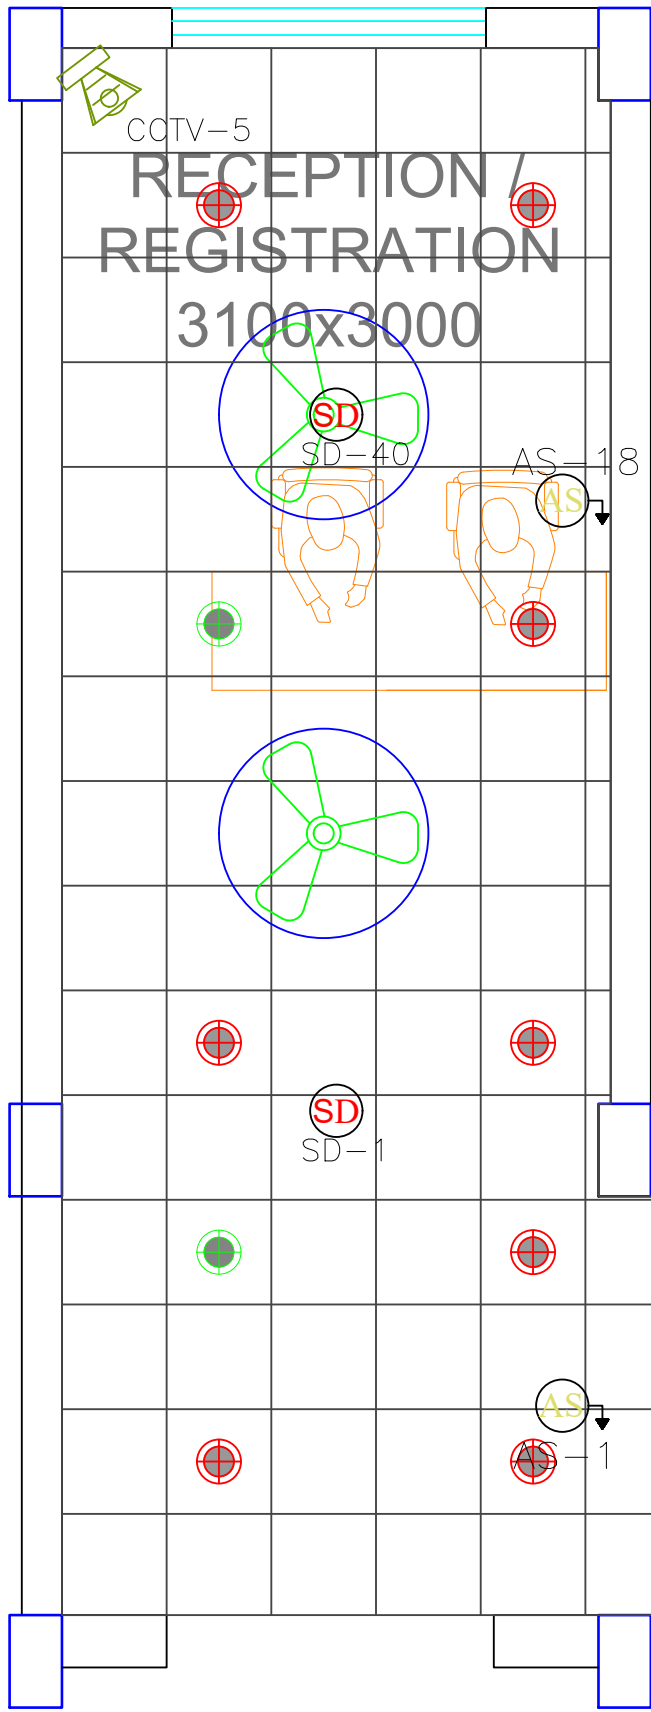


RCP

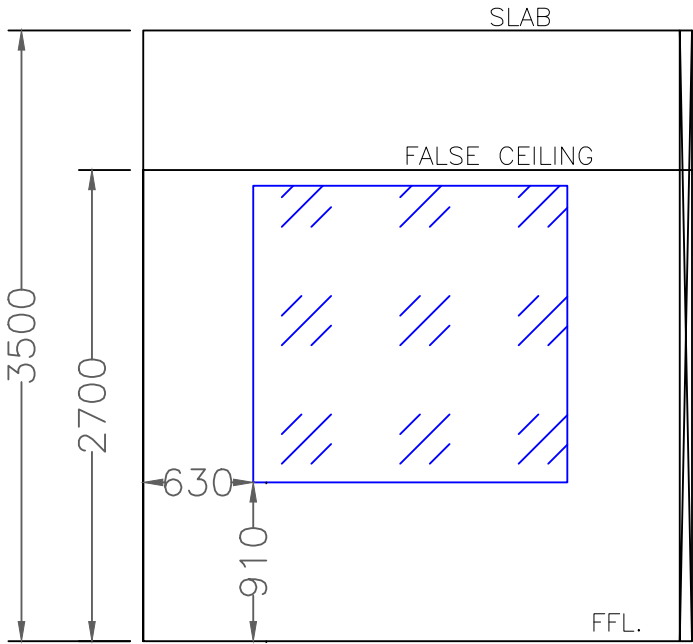


ELEVATION-1

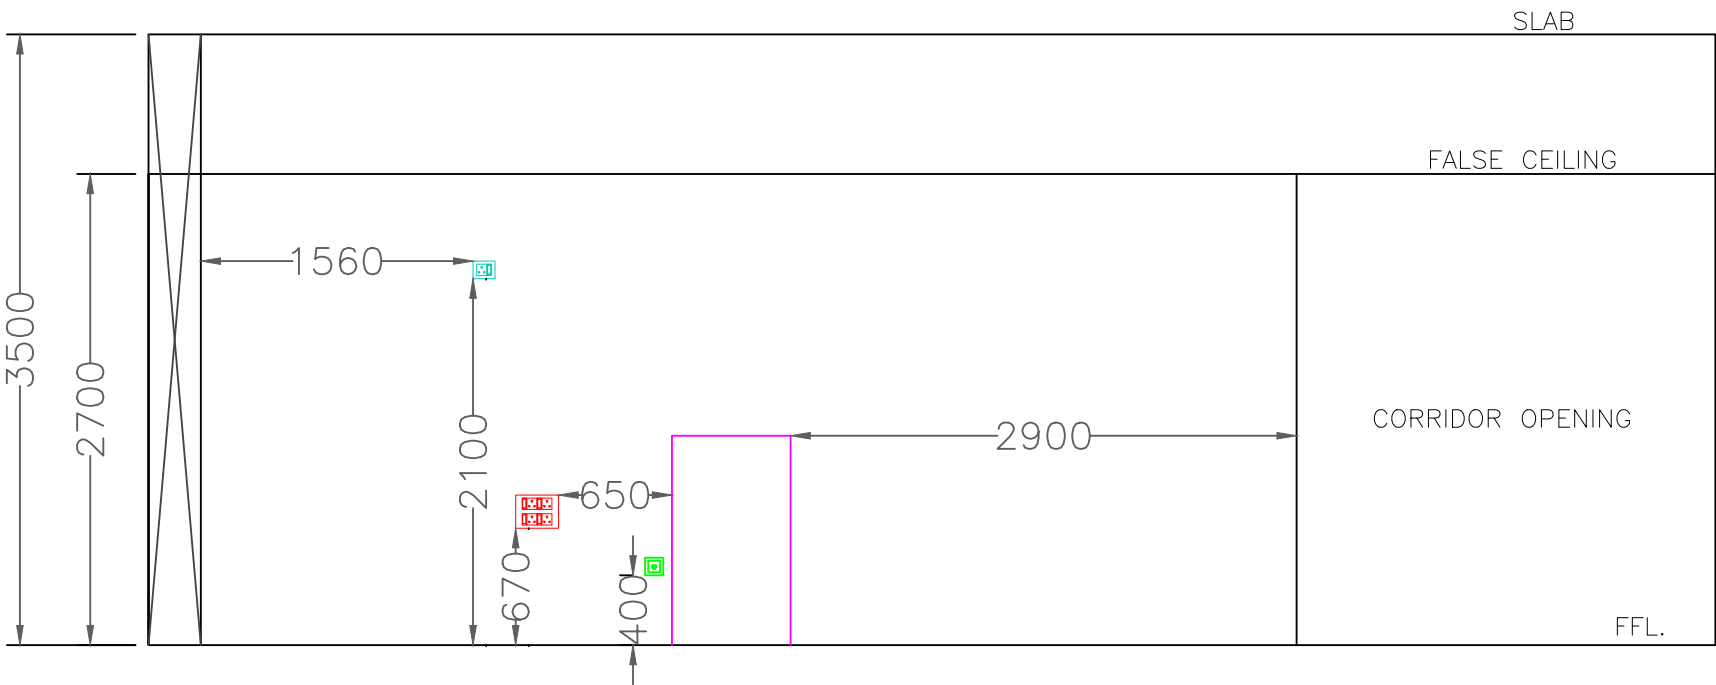


ELEVATION-2

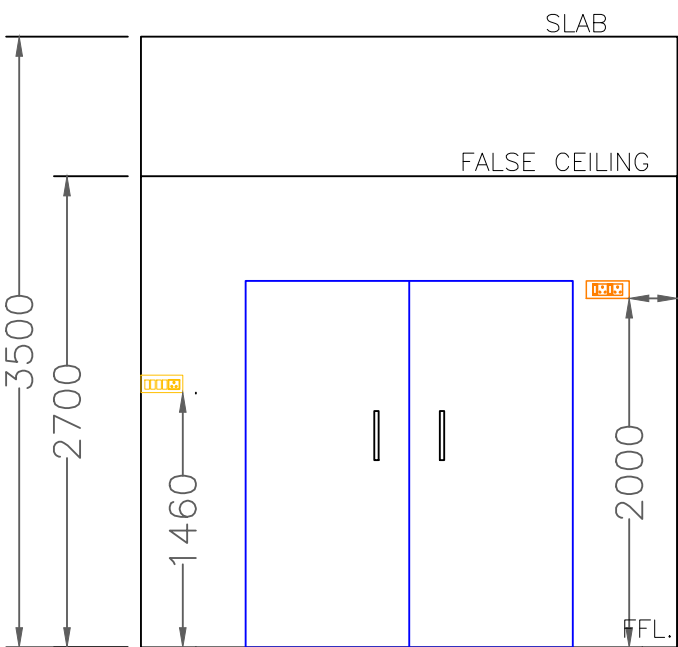

ELEVATION-3

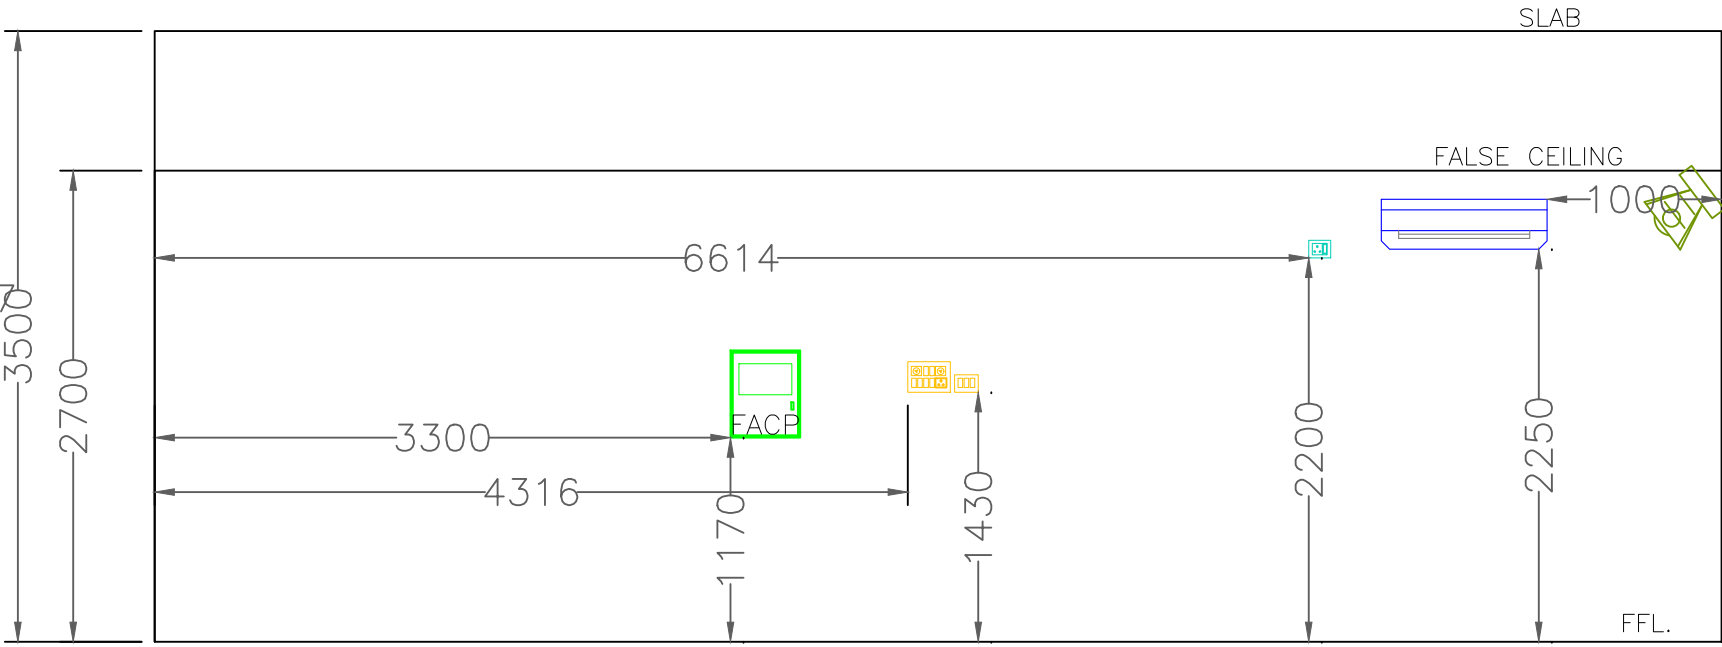

ELEVATION-4

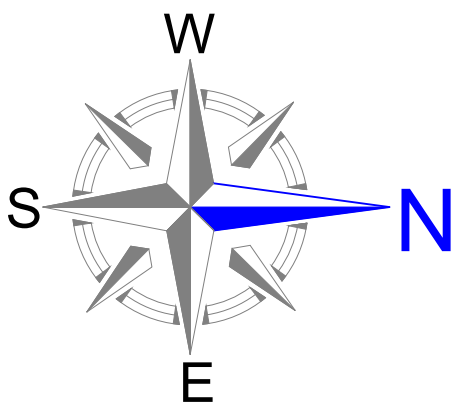

TITLE :
RECEPTION CORRIDOR
ELEVATION LAYOUT

PURPOSE OF DRAWING :-
PROPOSED ☐ FOR APPROVAL ☐
WORKING ☐ AS BUILT ☒

CLIENT :
TELANGANA STATE MEDICAL
SERVICES AND INFRASTRUCTURE
DEVELOPMENT CORPORATION.

DWG. No.:
AVC/TGMSIDC/IVFP/S/01
REV R1 DATE 17-06-2024
SCALE NTS SHEET 01

PROJECT :
IFV CENTER ON SECOND FLOOR IN
MOTHER & CHILD HOSPITAL BUILDING
BESIDE GANDHI HOSPITAL ,
SECUNDERABAD ,TELANGANA.

CONTRACTOR :
M/s Asta Vardhman Consortium
H. NO. 8-2-334/27, Plot No. 27,
Road No. 03, Banjara Hills,
Hyderabad - 500034
ASTA

