




PLAN

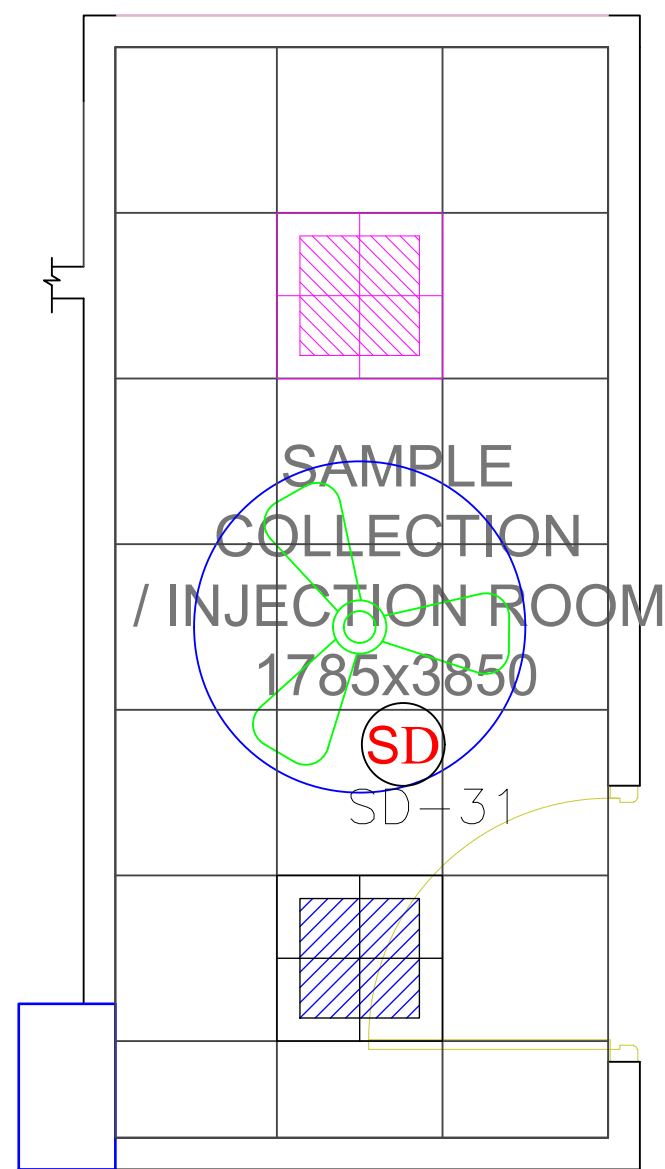


RCP

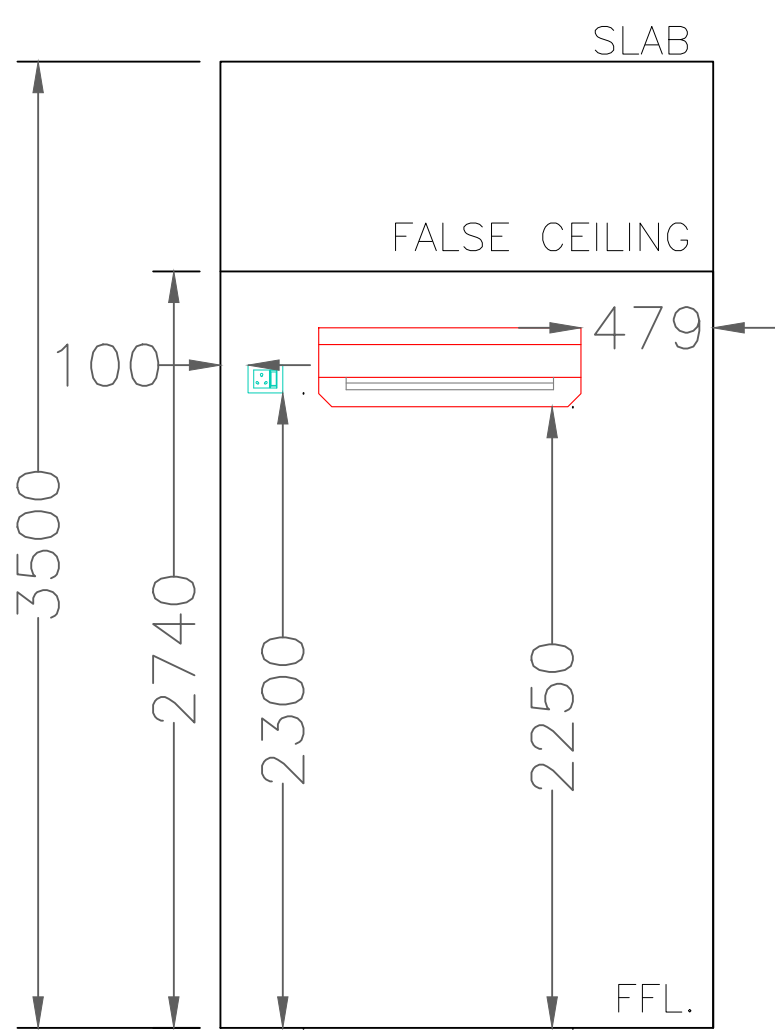


ELEVATION-1

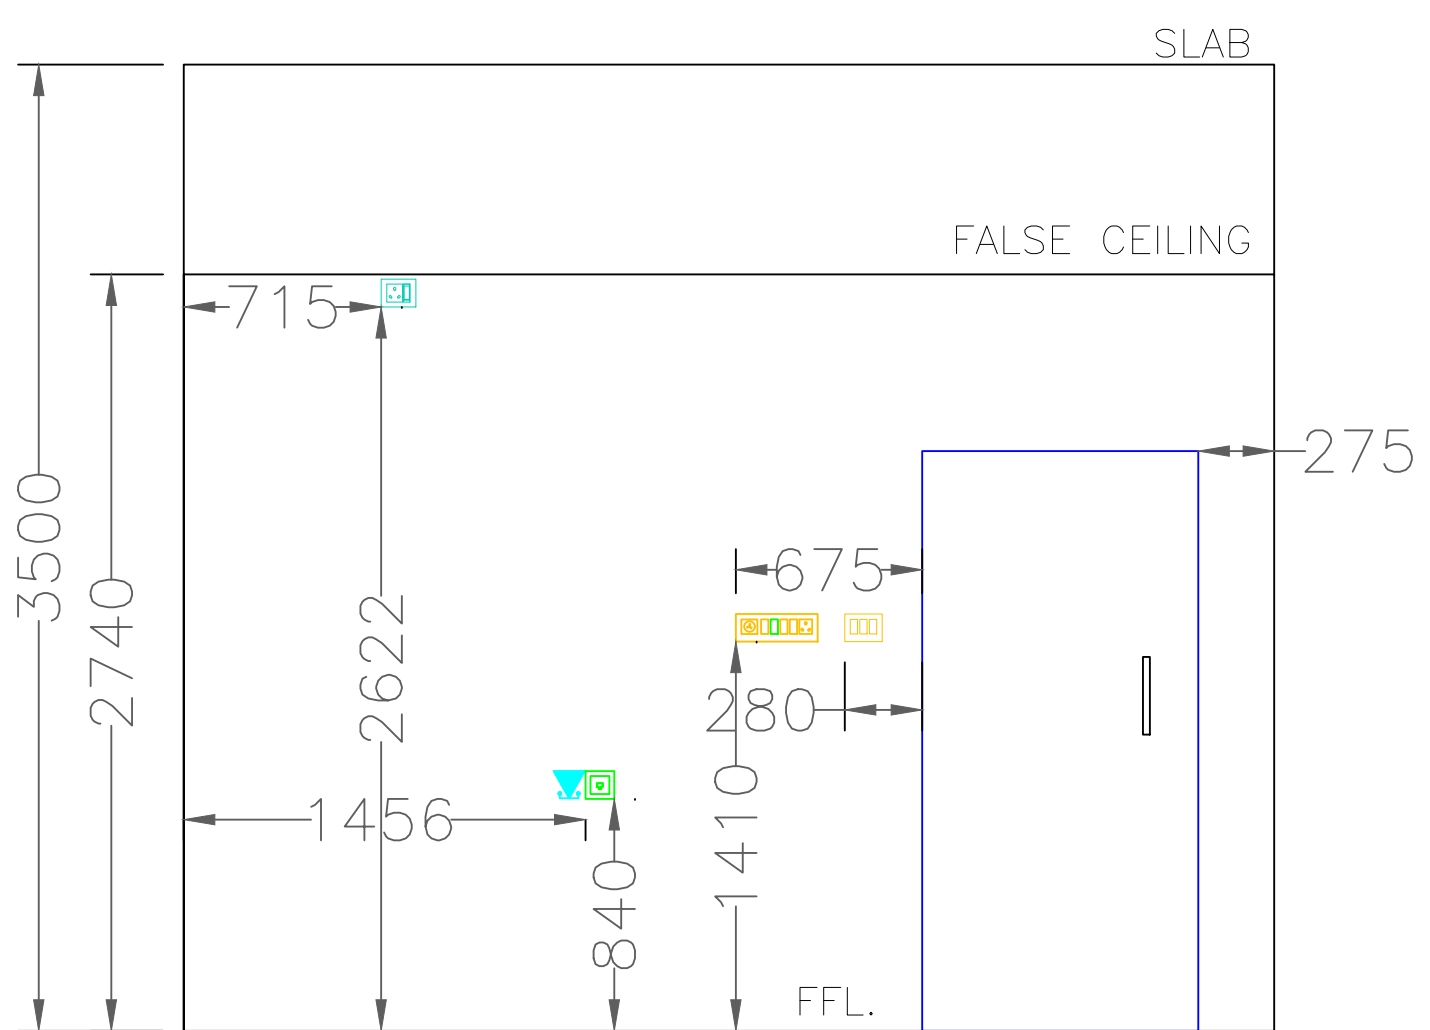


ELEVATION-2

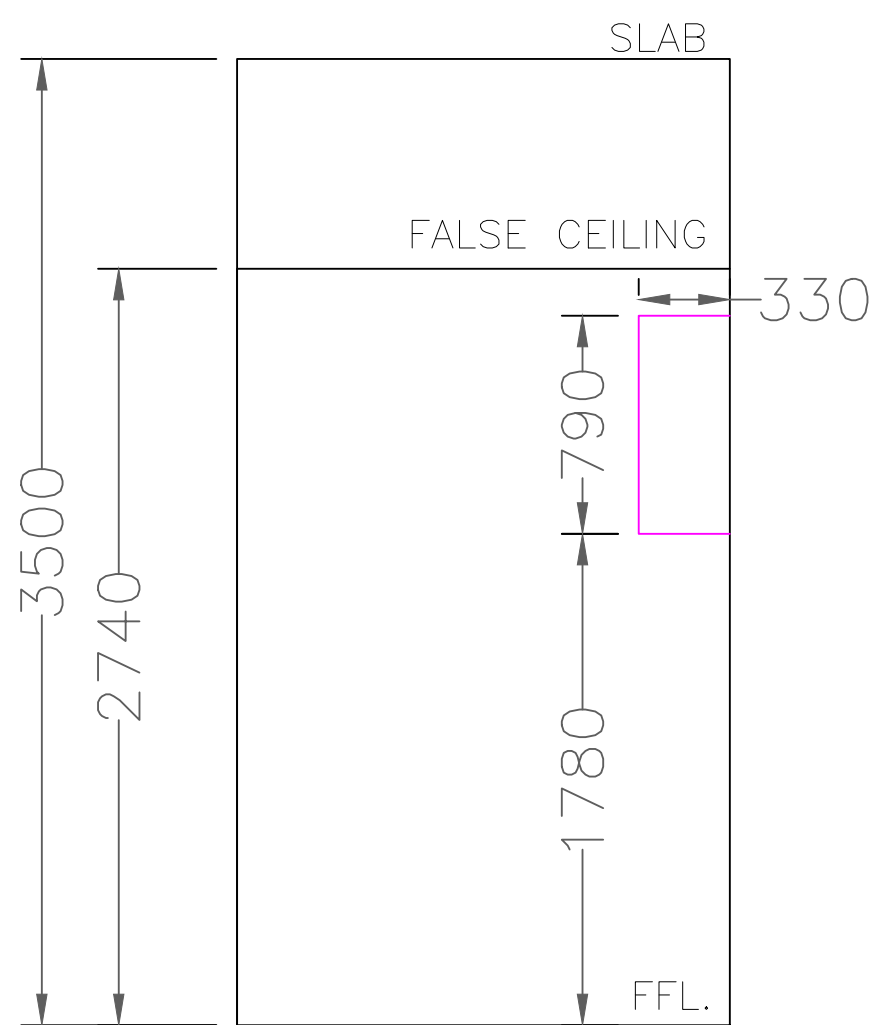

ELEVATION-3

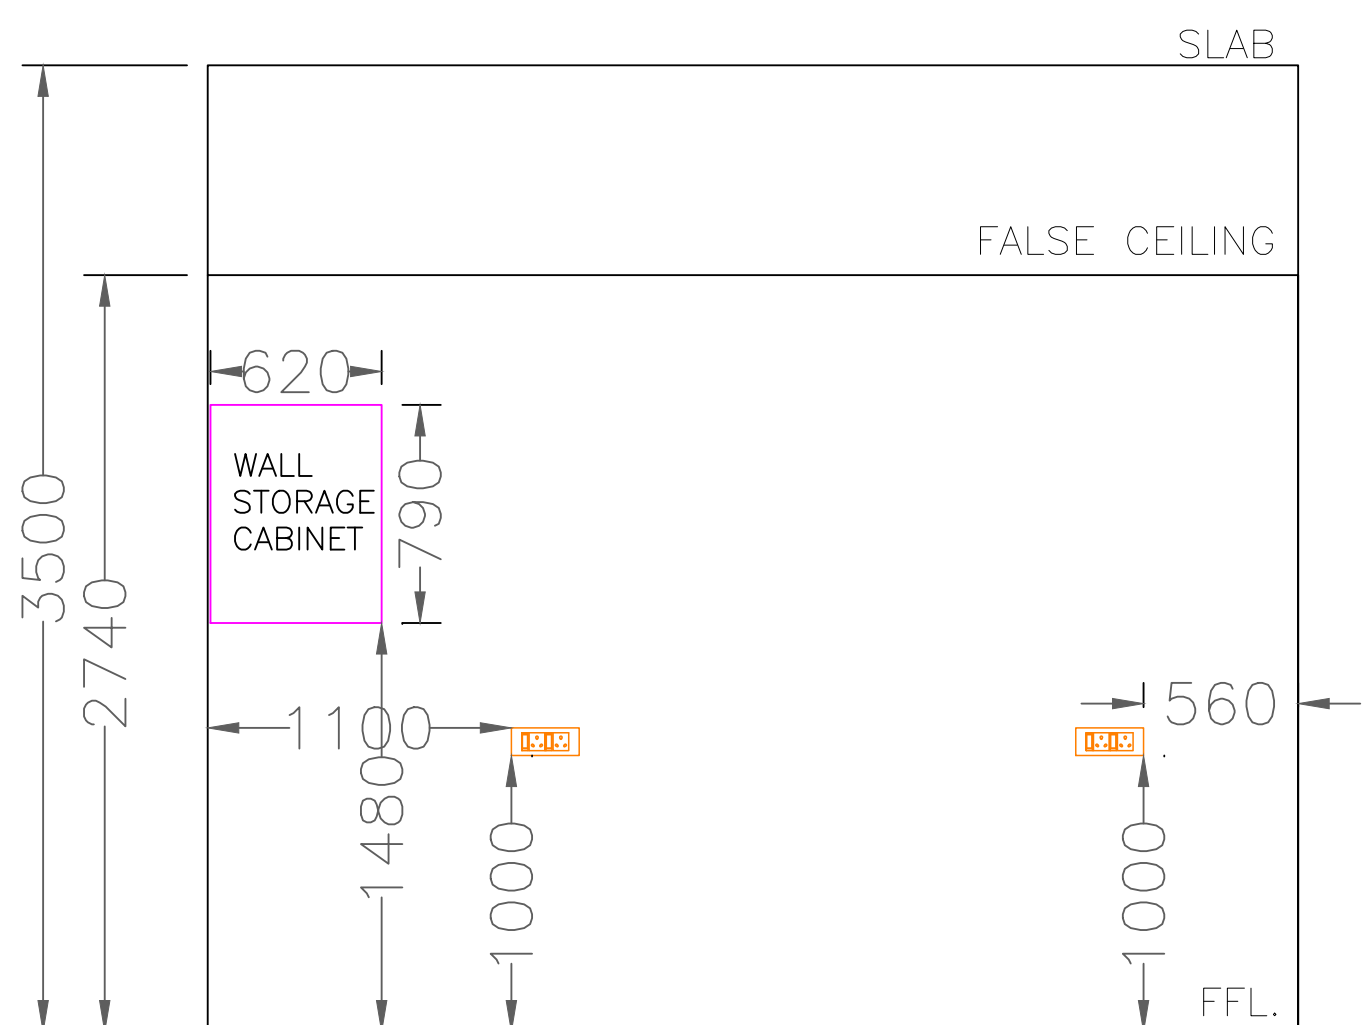

ELEVATION-4

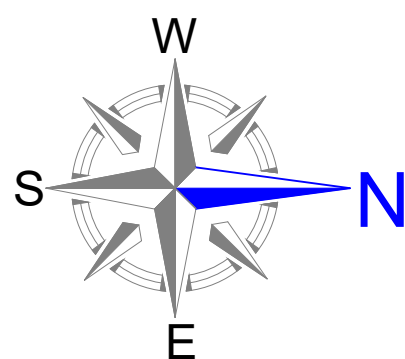

**TITLE :**  
SAMPLE COLLECTION ROOM  
CORRIDOR ELEVATION  
LAYOUT

**PURPOSE OF DRAWING :-**

**PROPOSED** ☐ **FOR APPROVAL** ☐

**WORKING** ☐ **AS BUILT** ☒

**CLIENT :**

TELANGANA STATE MEDICAL  
SERVICES AND INFRASTRUCTURE  
DEVELOPMENT CORPORATION.

DWG. No.:

AVC/TGMSIDC/IVFP/S/08

REV R1 DATE 17-06-2024

SCALE NTS SHEET 8

**PROJECT :**

IFV CENTER ON THIRD FLOOR IN MODERN  
GOVERNMENT MATERNITY HOSPITAL,  
PETLABURJ, HYDERABAD ,TELANGANA.

**CONTRACTOR :**



M/s Asta Vardhman Consortium  
H. NO. 8-2-334/27, Plot No. 27,  
Road No. 03, Banjara Hills,  
Hyderabad - 500034

