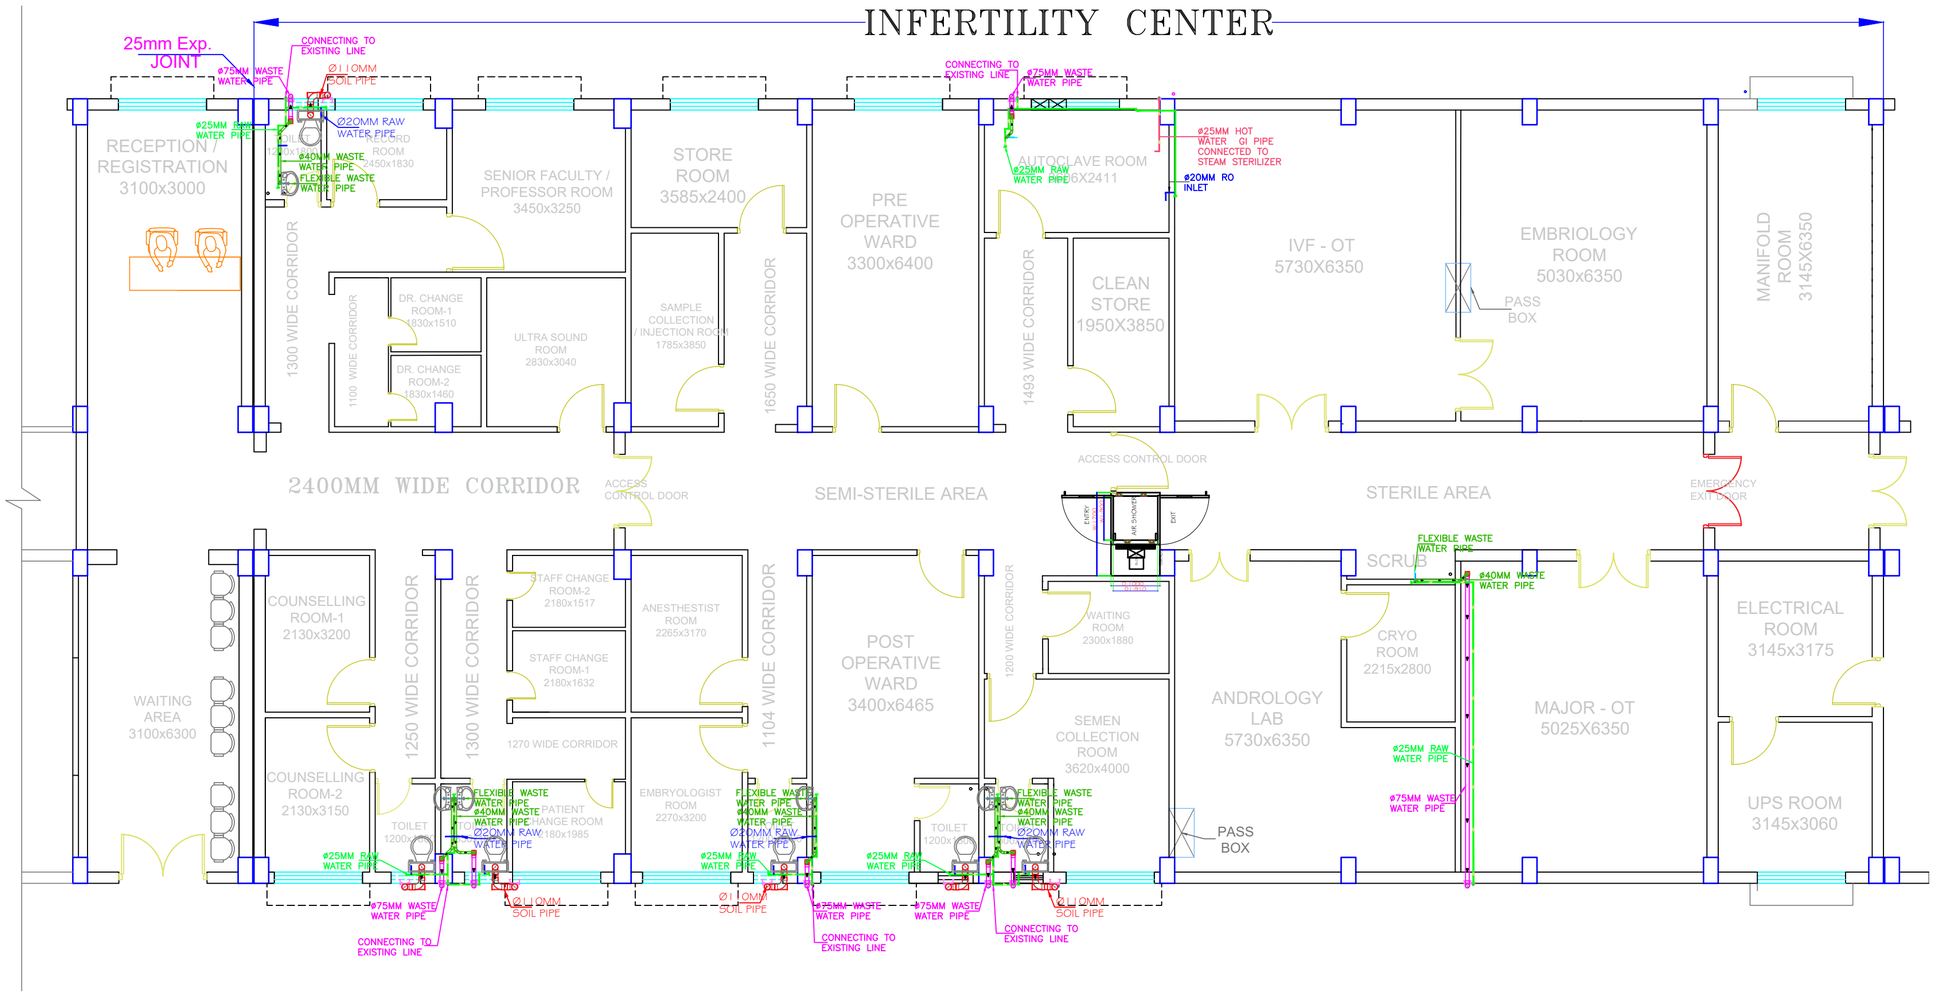


## PLUMBING LEGEND

| | |
|---|---|
| | 40MMØ WASTE WATER PIPE |
| WP | 75MMØ WASTE WATER PIPE |
| SP | 110MMØ SOIL PIPE |
| | FLOW DIRECTION |
| | 75MMØ FLOOR TRAP |
| | PLUMBING PIPE SUPPORT CLAMP |

## SUPPLY WATER LEGEND

| | |
|---|---|
| | 25MMØ SUPPLY RAW WATER PIPE |
| | 20MMØ SUPPLY RAW WATER PIPE |
| | 25MMØ HOT WATER GI PIPE |
| | FLOW DIRECTION |
| | PLUMBING PIPE SUPPORT CLAMP |

N
W E
S

PROJECT :

# IVF CENTER IN THIRD FLOOR OF MODERN GOVERNMENT MATERNITY HOSPITAL AT PETLABURZ, HYDERABAD, TELANGANA STATE.

CLIENT :

TELANGANA STATE MEDICAL SERVICES AND INFRASTRUCTURE DEVELOPMENT CORPORATION.

TITLE :

## THIRD FLOOR PLUMBING LAYOUT

**PURPOSE OF DRAWING :-**

**PROPOSED** ☐ **FOR APPROVAL** ☐

**WORKING** ☐ **AS BUILT** ■

| | | | |
|---|---|---|---|
| DATE | 20.06.2024 | DWG. No.: | AVC/TGMSIDC/IVFP/P/01 |
| DRAWN | MANOHAR | | |
| CHECKED | | REV | R2 |
| APPROVED | | SCALE | NTS |

CONTRACTOR :

ASTA

M/s Asta Vardhman Consortium
H. NO. 8-2-334/27, Plot No. 27,
Road No. 03, Banjara Hills,
Hyderabad - 500034