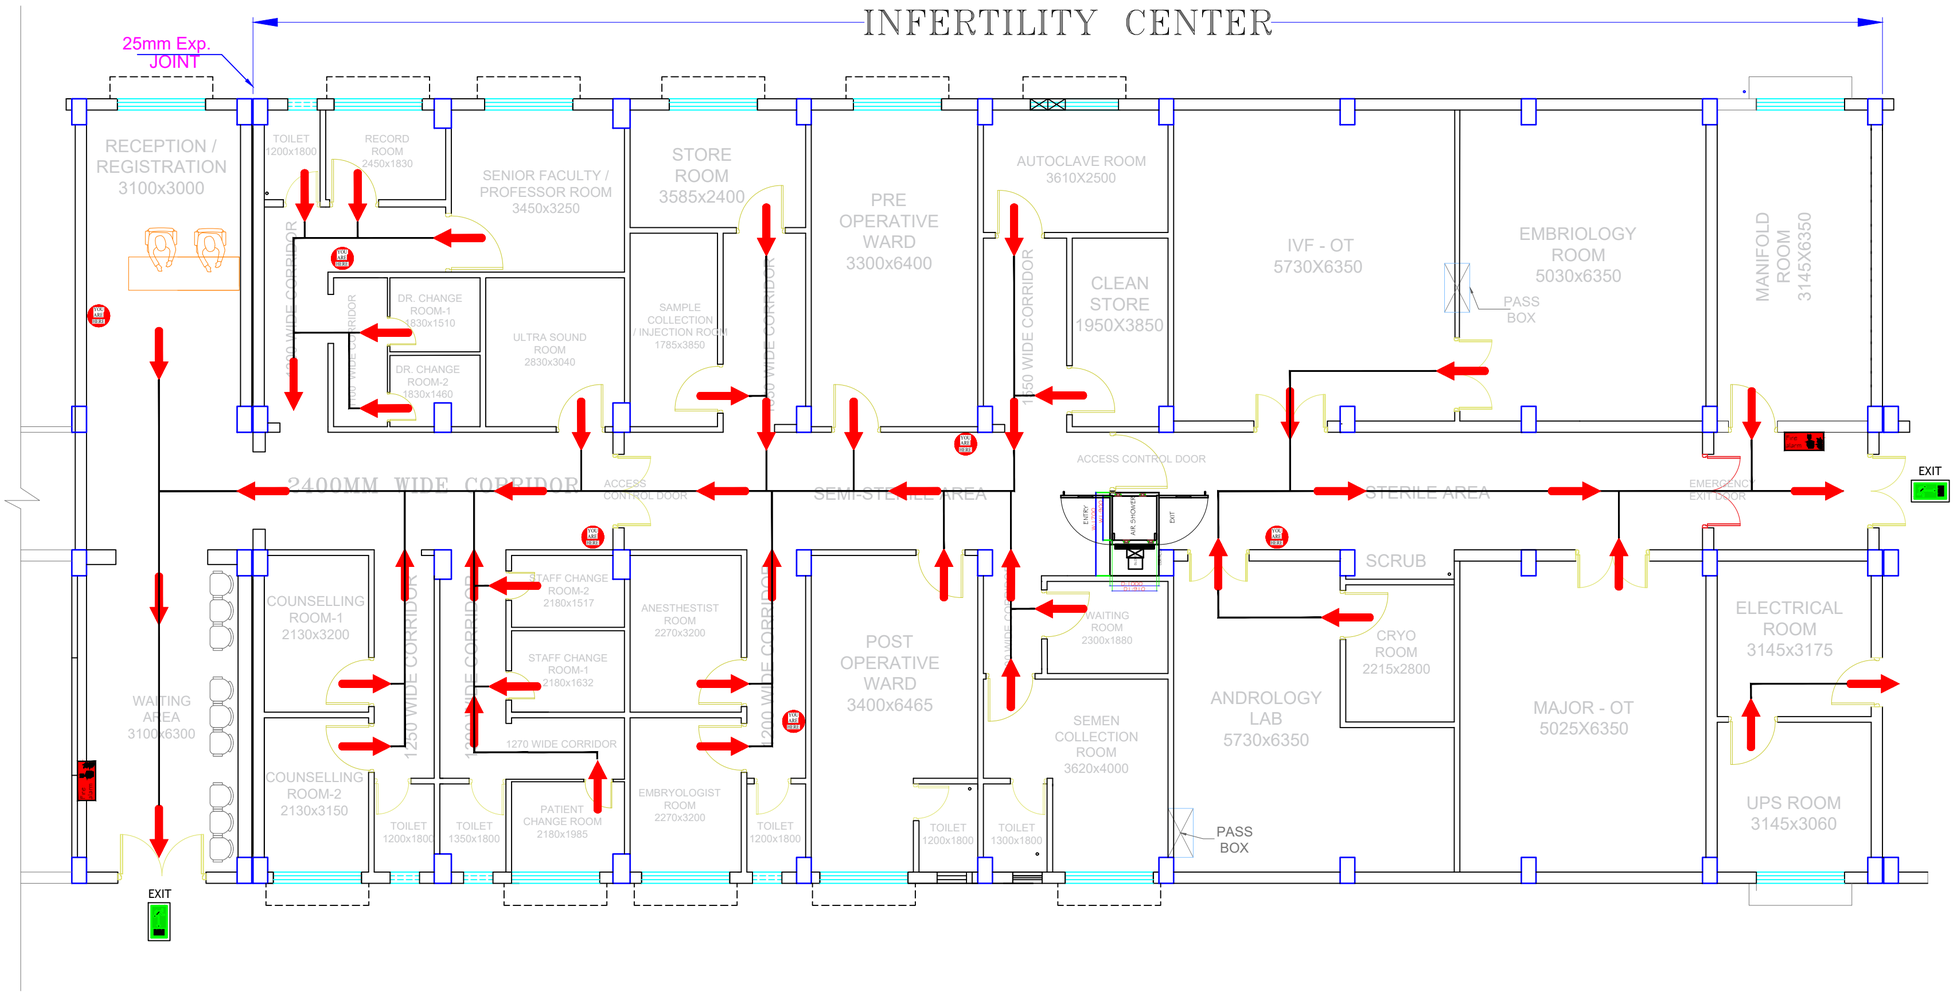

FIRE EVACUATION LEGEND:

S.NO	SYMBOL	DESCRIPTION
01.		FIRE ESCAPE
02.		FIRE ALARM
03.		EXIT

PROJECT :

IVF CENTER IN THIRD FLOOR OF MODERN GOVERNMENT MATERNITY HOSPITAL AT PETLABURZ, HYDERABAD, TELANGANA STATE.

CLIENT :

TELANGANA STATE MEDICAL SERVICES AND INFRASTRUCTURE DEVELOPMENT CORPORATION.

TITLE :

THIRD FLOOR FIRE EVACUATION LAYOUT

PURPOSE OF DRAWING :-

PROPOSED ☐ **FOR APPROVAL** ☐

WORKING ☐ **AS BUILT** ☒

DATE	17.06.2024	DWG. No.:	AVC/TGMSIDC/IVFP/ELE/05
DRAWN	MANOHAR		
CHECKED		REV	R1
APPROVED		SCALE	NTS

CONTRACTOR :

ASTA

M/s Asta Vardhman Consortium
H. NO. 8-2-334/27, Plot No. 27,
Road No. 03, Banjara Hills,
Hyderabad - 500034