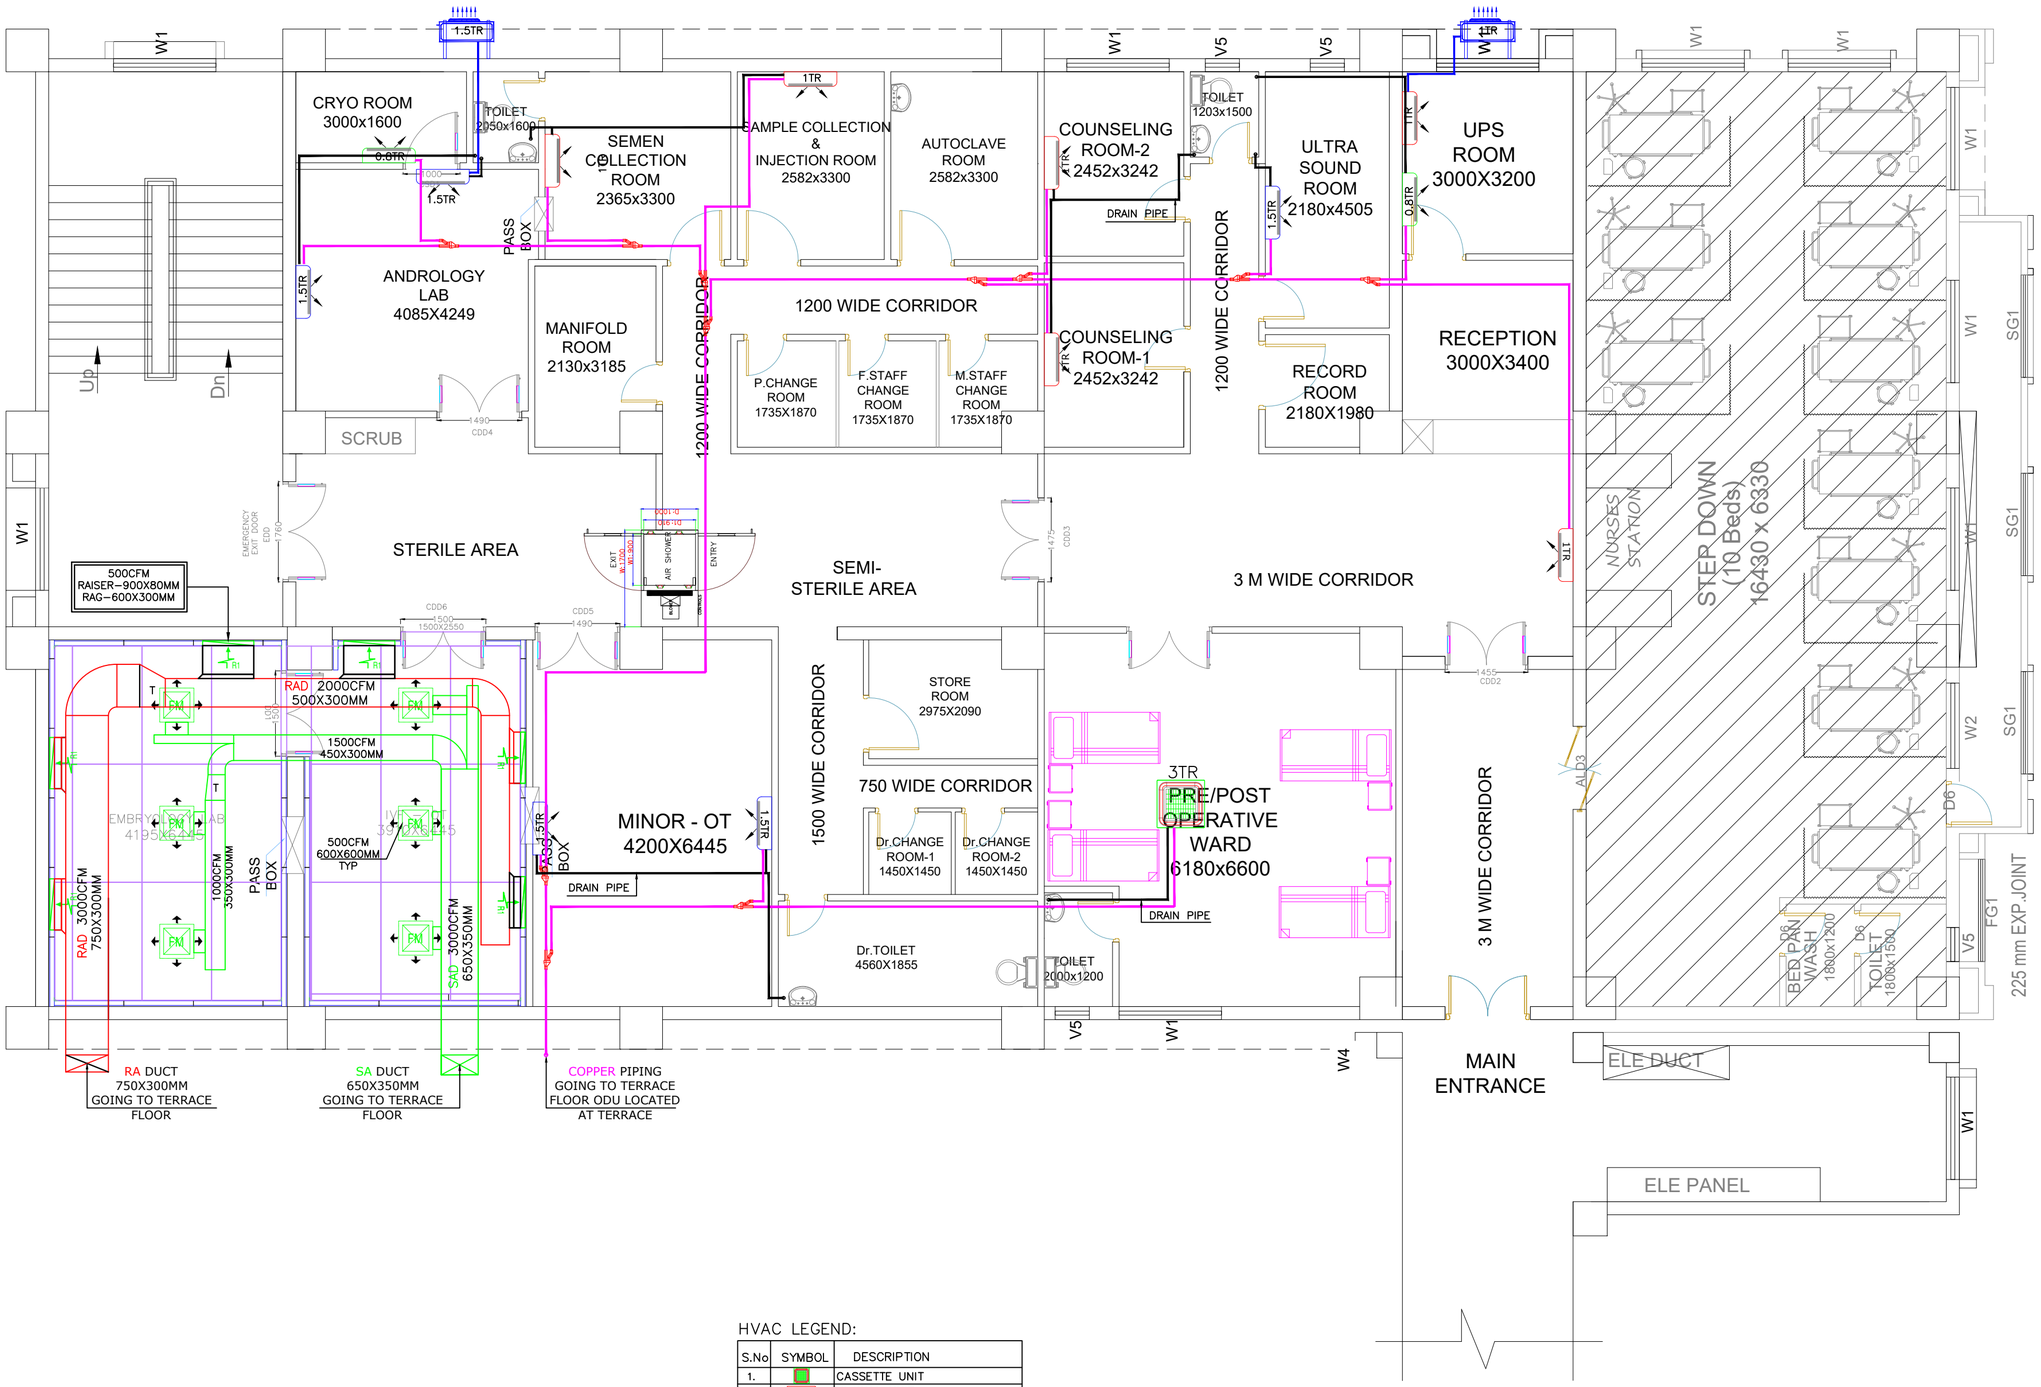

HVAC LEGEND:

S.No	SYMBOL	DESCRIPTION
1.		CASSETTE UNIT
2.		HI WALL UNIT
3.		SUPPLY AIR DUCT
4.		RETURN AIR DUCT
5.		SA FILTER MODULE
6		RETURN RAISER
7		COPPER PIPE
8		VRF COPPER PIPE
9		DRAIN PIPE
10		REFNET JOINT
11		OUTDOOR UNIT
12		VRF OUTDOOR UNIT
13		AIR HANDLING UNIT
14		OUTDOOR UNIT
15		AC PANEL

W S N E

TITLE :	CLIENT :	PROJECT :
HVAC LAYOUT	TELANGANA STATE MEDICAL SERVICES AND INFRASTRUCTURE DEVELOPMENT CORPORATION.	IFV CENTER ON SECOND FLOOR IN MOTHER & CHILD HOSPITAL BUILDING BESIDE GANDHI HOSPITAL , SECUNDERABAD ,TELANGANA.

PURPOSE OF DRAWING :-
PROPOSED ☐ FOR APPROVAL ☐
WORKING ☐ AS BUILT ☒

DWG. No.: AVC/TGMSIDC/IVFG/ELE/07

REV	R5	DATE	20-06-2024
SCALE	NTS	SHEET	10

CONTRACTOR :
ASTA
M/s Asta Vardhman Consortium
H. NO. 8-2-334/27, Plot No. 27,
Road No. 03, Banjara Hills,
Hyderabad - 500034