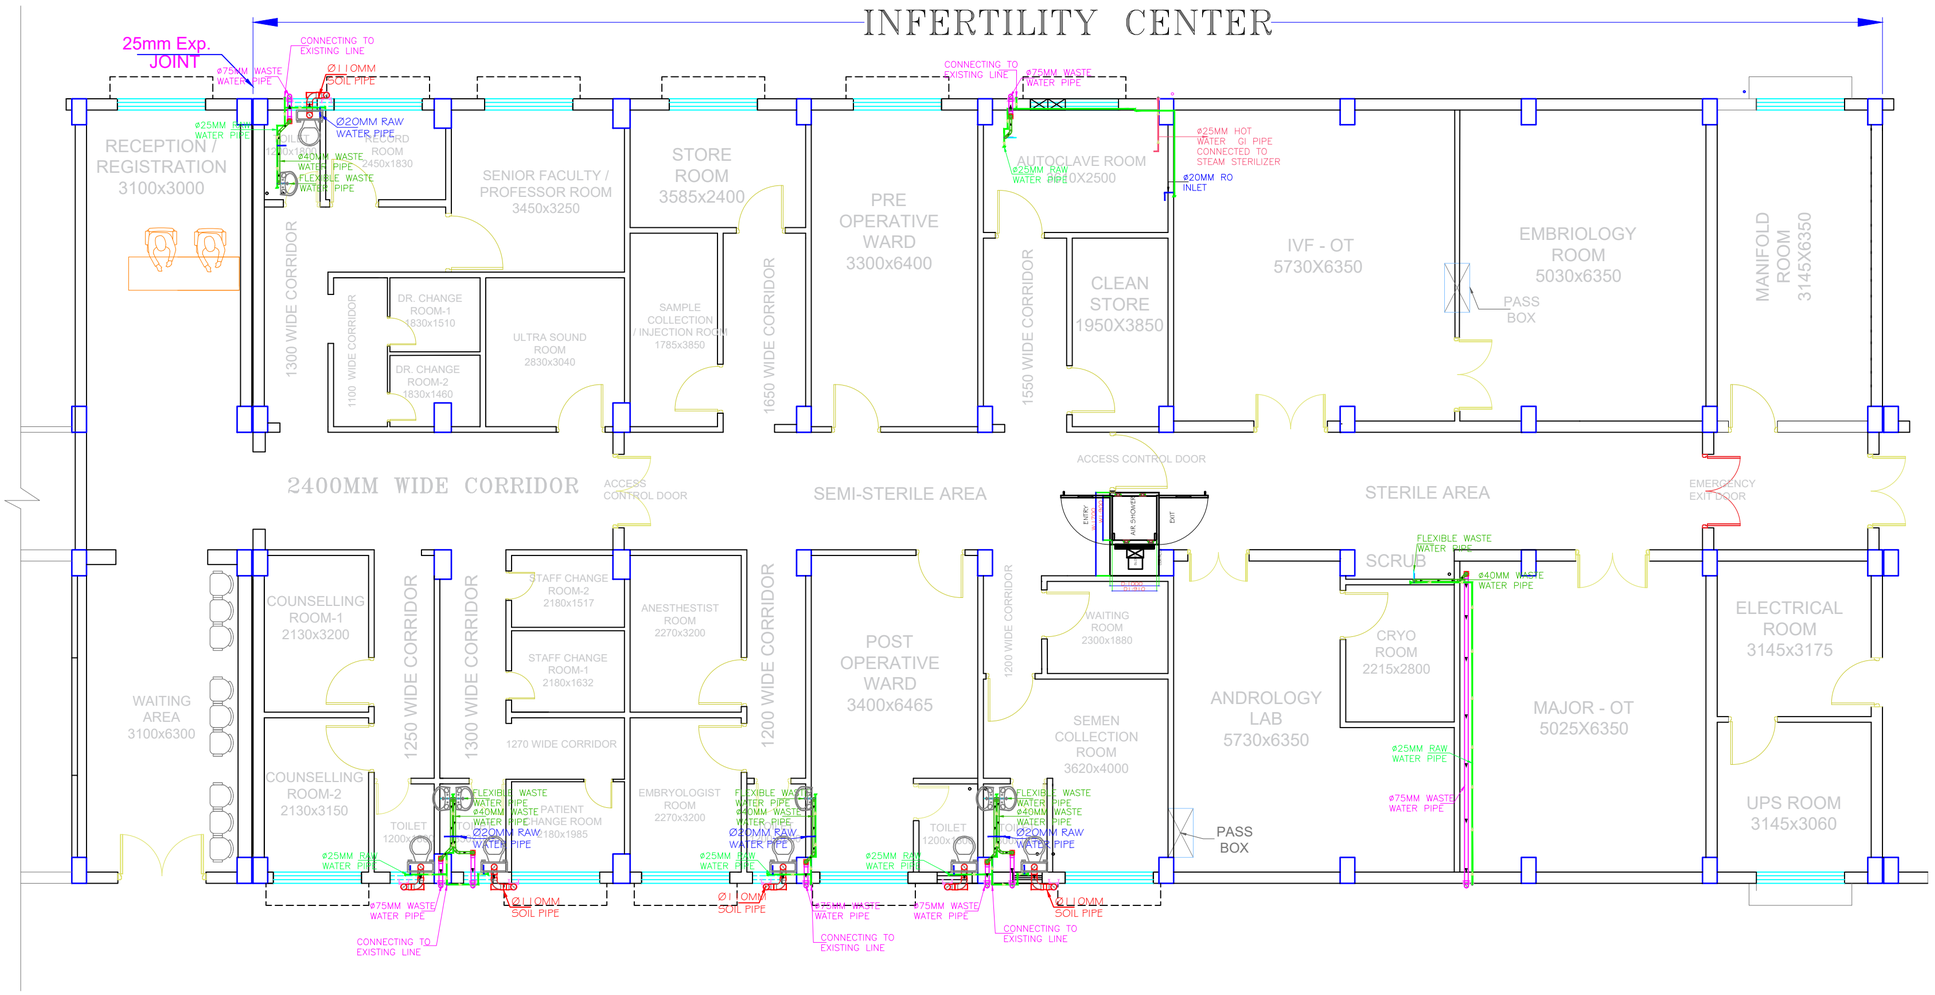

PLUMBING LEGEND

	40MMØ WASTE WATER PIPE
WP	75MMØ WASTE WATER PIPE
SP	110MMØ SOIL PIPE
	FLOW DIRECTION
	75MMØ FLOOR TRAP
	PLUMBING PIPE SUPPORT CLAMP

SUPPLY WATER LEGEND

	25MMØ SUPPLY RAW WATER PIPE
	20MMØ SUPPLY RAW WATER PIPE
	25MMØ HOT WATER GI PIPE
	FLOW DIRECTION
	PLUMBING PIPE SUPPORT CLAMP

PROJECT :

IVF CENTER IN THIRD FLOOR OF MODERN GOVERNMENT MATERNITY HOSPITAL AT PETLABURZ, HYDERABAD, TELANGANA STATE.

CLIENT :

TELANGANA STATE MEDICAL SERVICES AND INFRASTRUCTURE DEVELOPMENT CORPORATION.

TITLE :

THIRD FLOOR PLUMBING LAYOUT

PURPOSE OF DRAWING :-

PROPOSED ☐ **FOR APPROVAL** ☐

WORKING ☐ **AS BUILT** ■

DATE	17.06.2024	DWG. No.:	AVC/TGMSIDC/IVFP/P/01
DRAWN	MANOHAR		
CHECKED		REV	R1
APPROVED		SCALE	NTS

CONTRACTOR :

ASTA

M/s Asta Vardhman Consortium
H. NO. 8-2-334/27, Plot No. 27,
Road No. 03, Banjara Hills,
Hyderabad - 500034